C.S. # 969

Hardcopy 12-5 # 24

also see notes in file

F. B. 35-39

969

C.S. 257 Con.

F/B 35, PG. 39

C.S. 969

39

Survey for H. C. Newton
T. 12 S. R 5 W.

Set on point .067 W and .026 N of a ¾" pipe at the N.W. corner of Woodson's sight on N.W. corner of claim 78 .598 89°45'E measured from pipe to south line of Highway continued 13-258, thence to S.E. corner - measured N. 7.50 chs & set stake
Back to beginning
N 86° 38'E to R.W. stake 334+50 on sta 334+50 B.S. on 335 - turn 90°L 28.4 ft to intersection on R.W. with line.
N 86° 38'E
N 76° 43'E
N 76° 15'E

Sta 341+72.5
Sta 341+45
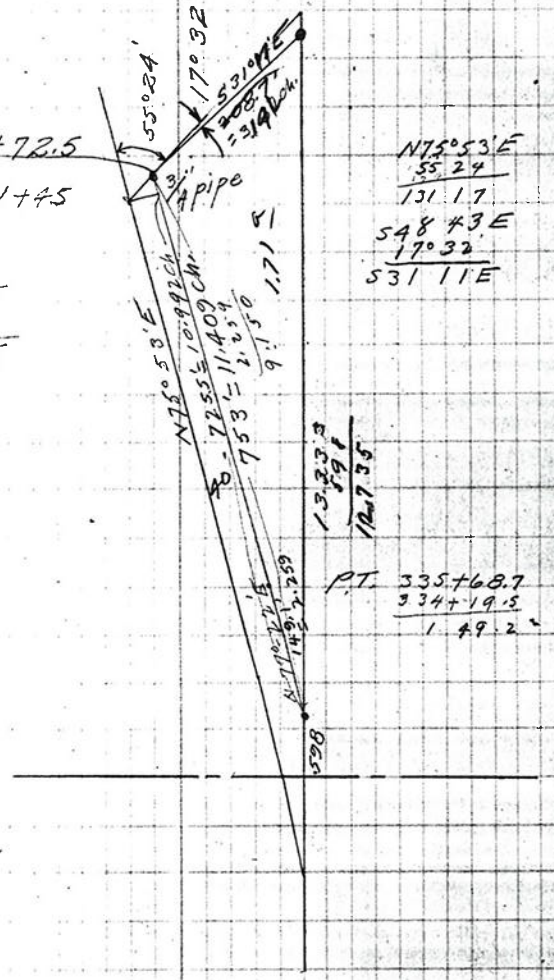
341+72.5
7 53
334 19.5