C.S. # 970

Hardcopy 10-4 # 16

also see notes in file

F. B. 35-40

970

F/B 35, PG 40

40
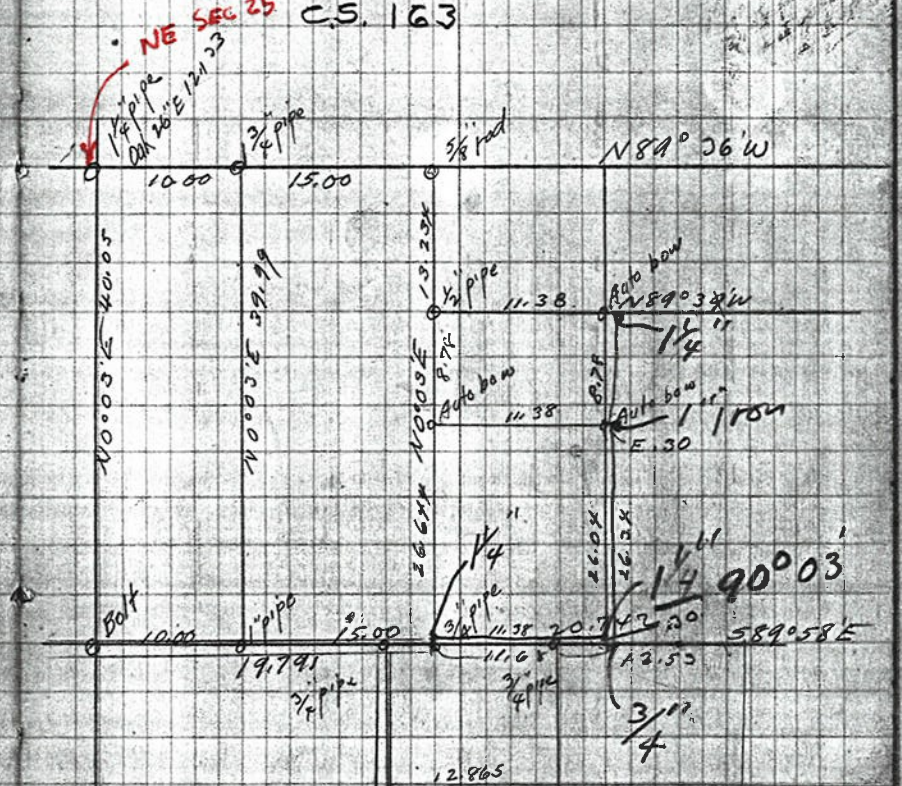
T. B. Radford 10-4
Sec 25
C.S. 163