C.S. # 971

See notes in file

F.B. 35-41

971

C.S. 971

F/B 35, P6 41

C S 200 41
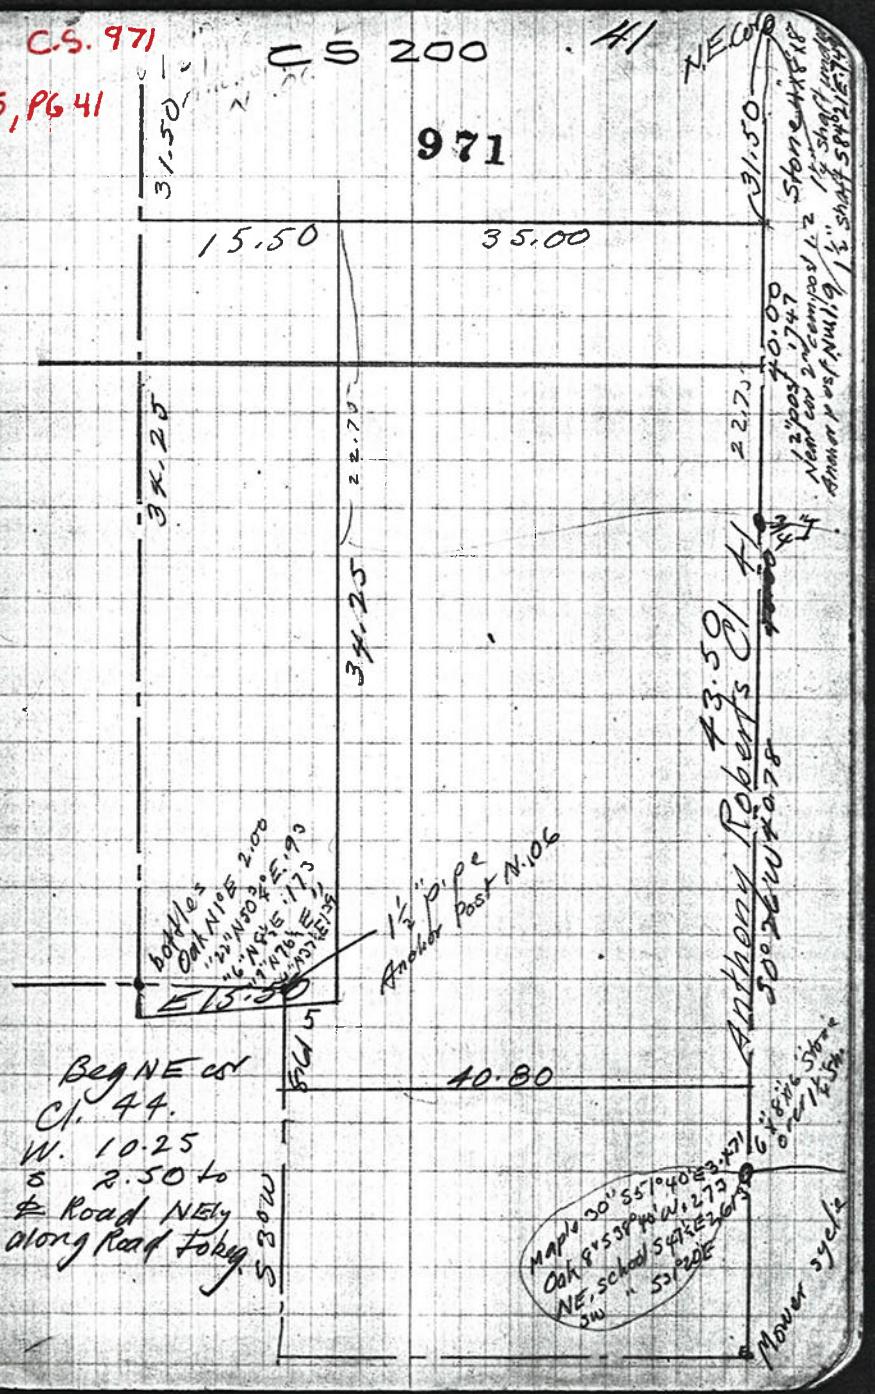
971