C.S. # 972

Hardcopy 12-4 # 2

also see notes in file

F. B. 35-42

972 : C.S. 132 FB#35

Survey for Mrs. A.L. Bier
T. 12 S R 5 W

N 42° W	1.58	
	6.00	4.42 Δ bnk 10' R
N 22° W	5.3	
	27	2.60
N 9½° W		7.80? along bank
N 16½ W		1.54' N 7° E 1.50'
Δ		20' S of R.R. S 45° E 80' R.R.
N 27° W		3.3
		6.0 2.70
Δ		150' W to R.R. 100' N of land.
		on gravel bar. 20' S of R.R.
S 89° W		S 72½ W bar and R.R. intersect 200'
		5.20
Δ		gone
		pipe on bank. ang R.R. N 73° W
S 67° W		witness trees, standing
		100
N 83° W		90'

witness tree on bank ready to carve in.

972
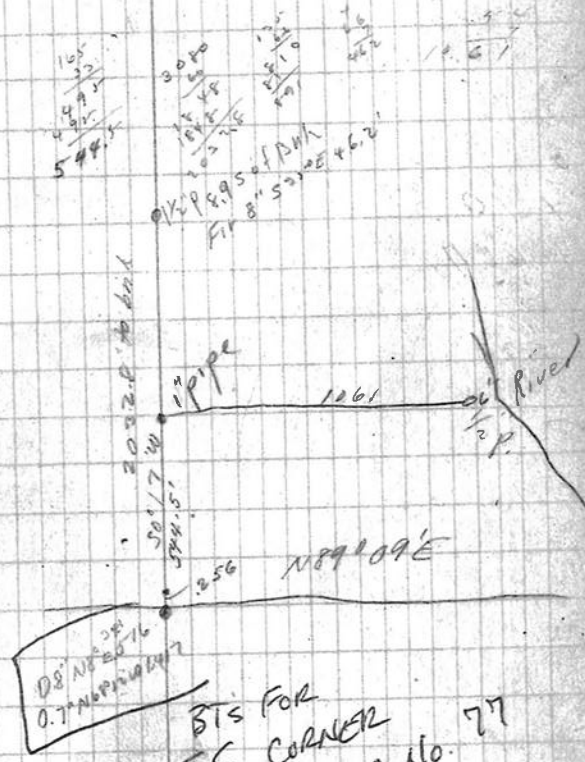
Beg at pt on E. line of T.G. Hogue Cl.
#77 33 KN. of S line of sec. 13 - Thn.
N. 22 R - E to Will. Riv. - Up Riv to E line of
sec. S. to pt E of beg, W. to beg.
Also beg. at pt on E line said Cl.
55 KN of S line sec. 13 - N 16 R - E to
Riv. - Up Riv to pt E. of beg. - W to beg.