C.S. # 974

Hardcopy 13-5 # 8

also see notes in file

F. B. 35-50

974 FB #35 C.S. 70

Survey for Glenn Starr
Elizabeth Herbert C/4 T. 13 S R. 5 W.
Began at 1" pipe A. 6.652
S. of jog in road: Cont. S.

481.0 7.288

89°45' E

726.8' 11.012

92°25' R

7.861 11.911

2.654 = 4.021

88°34' R

82.4 1.248

6°11' L

3.337 5.056

90°24' L

447.4 6.779

Set 14.0 S, 18.W 1½" pipe

Set ¼" pipe Auto Bow North 70.3

+ 100' to creek
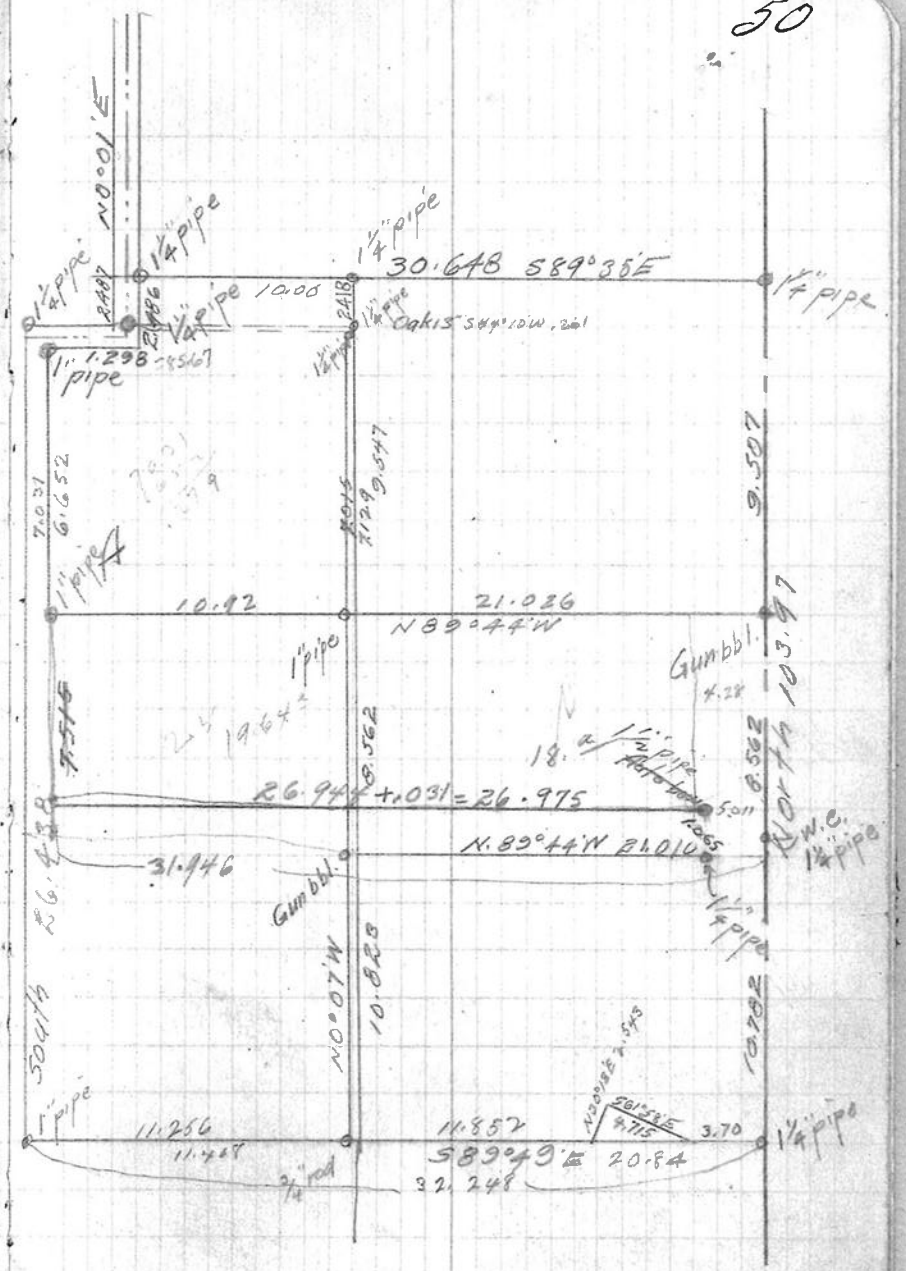
447.4
35.9
483.3
481.0
2.3