C.S. # 975

Hardcopy 12-5 # 30

also see notes in file

F. B. 35-51

35

POSTS

FIELD BOOK

No. 385

C.S. 25

975

Survey for Mrs. Tennison
J.G. Alexander Cl. 46

12503
32.4
870.5
311.2 2464.4
0

hit 1.3 W of pine

85°42' init. ang

310.9 = 4.711
180.9 = 2.741

336.9 5.105'

180 = 1.970

1.964 X 5.105

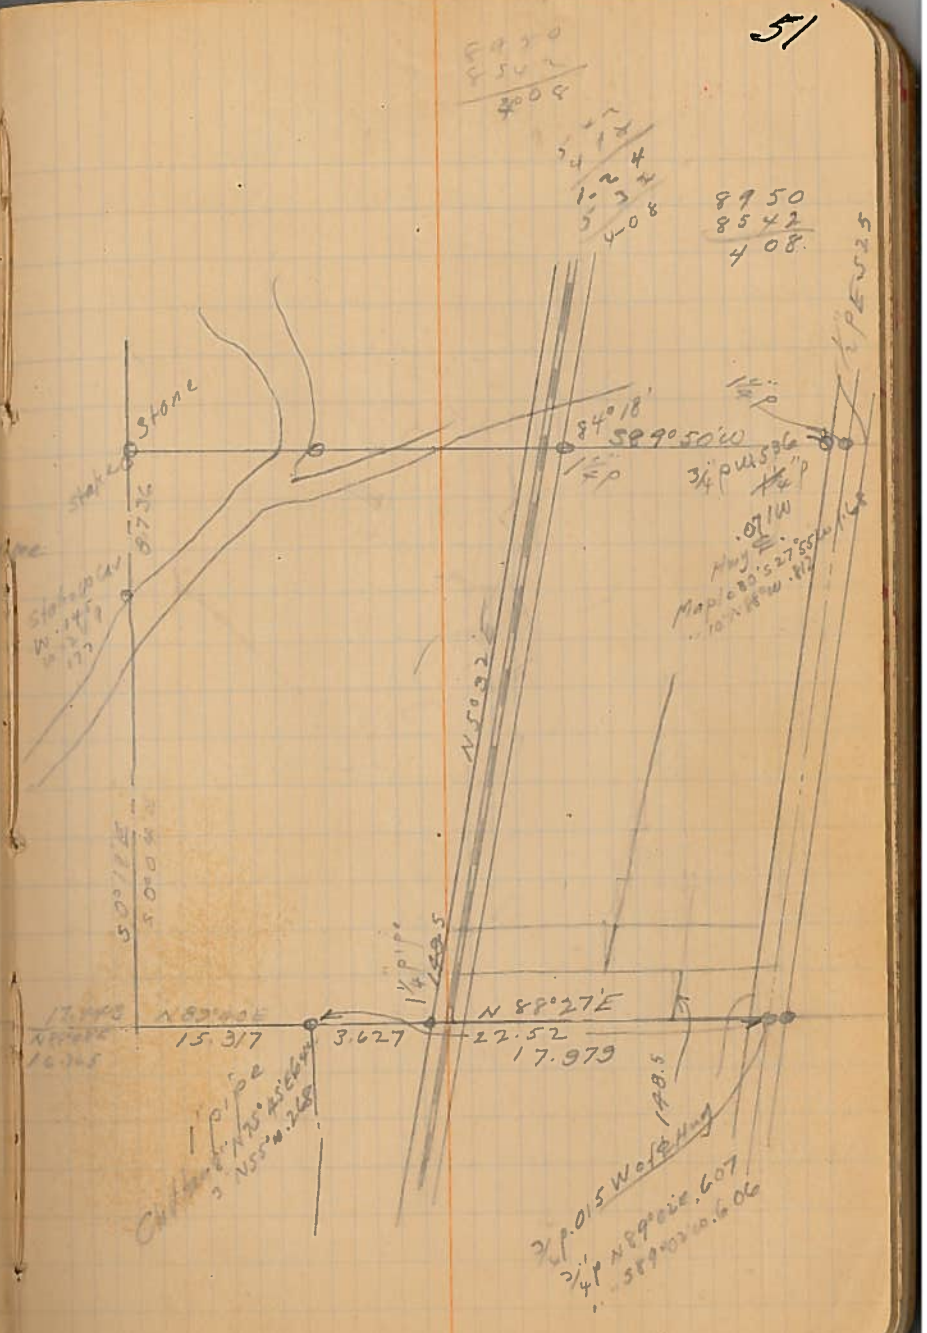

51

Assume Level of Mill Race Bridge as 218

H.I. = 224.5

A	Dist	Elev	FS	
	S.W cor	205.0	19.5	hit 2½ x ht. of boxes above mailboxes
277°50'				Maple
289°10'	3.60	223.5	1.0	"
299°10'		23.0	1.5	"
308°30'	4.60	21.3	3.2	Tel pole
339°50'	3.15	14.9	9.6	ditch line S 20° W
1° 05'	2.95	18.7	6.1	fence cor
40° 15'	3.80	19.3	5.2	"
67° 05'	7.20	16.0	8.5	" Cedar brush
82° 30'	7.00	16.5	8.0	" "
93° 05'	7.32	20.7	3.8	
105° 10'		22.7	1.8	Gate post N by RR fence
111° 35'	8.10?	20.4	4.1	angle in fence
115° 15'	7.30	18.0	6.5	bottom
108° 0'	4.65	17.5	7.0	angle in fence
119° 0'	3.65	18.6	5.9	" "
118° 0'	3.10	15.5	9.0	intersection of ditches
132° 20'	3.15	19.1	5.4	fence cor turns 105' N to fence 1 rod to barn
136° 15'	1.75	20.1	4.4	old fence run E + W.
122° 20'	.82	17.3	7.2	bottom of ditch
91° 20'	1.52	15.7	8.8	" " " intersects above ditch
16° 0'	1.32	15.4	9.1	Cor fence
177° 20'	1.95	21.3	3.2	N.W. Cor Barn
195° 33'	2.10	22.8	1.7	NE " shed
201° 28'	2.30	22.6	1.9	NW cor garden

201°-0'	2.90		22.5	2.0
217°35'	3.60		22.6	0.9
218°40'				
220°35'				
225°10'			24.0	0.5
228°55'				
253°22'			24.2	0.3
265°20'			24.2	0.3
270°30'	3.00		22.2	2.3
282°0'				
290°30'	2.10		20.7	3.8
273°50'	1.90		21.2	3.3
			18.8	5.7
	Set on point 1200' N of			
	45			
	90			
	1.50			
	2.85			
	2.20	Azimuth from here on correct 8°16' Right	H.I. = 33.5	
		7.0' higher than former set		
	Set on pavement 1.0 W of			
177°46'	3.10		28.1	3.4
176°	2.15			
174°30'	2.25			
173°50'	2.00			

SW. Cor garden by barn drive
S.W Cor Garage
NW " "
NE " "
NE Cor front garden fence
NE Cor House
Maple by road
" " "
SE Cor Fish pond
NE " " "
NW " " "
SW " " "
bottom " "
S.E. Cor Tumbledown road
Maple
" 45' from ℄ Hwy
"
" 4°08' on highway turned wrong dir.
SE Cor garden fence 40 from ℄ Hwy
- window sill Apostle = 2nd row board above apron below window
- bottom board on South Side
W side H.I. = bottom Auto port Sign
pipe at SE. cor tumbledown
Apple Tree
Maple small 20'
" 30'

		Elev		
167°05'	130			Maple large
178	+63			"
72°	40	226.4	5.1	"
90°	18	22.3	9.2	highway ditch
	370	20.7	10.8	"
9°45'	370	25.7	5.8	Maple large
25°	430	22.3	9.2	dead furrow
32°	470	24.6	6.9	ground level
67°	250	25.0	6.5	" "
67'	185	23.9	7.6	dead furrow
155°15'	3.60	25.1	6.4	
140°45	4.55	26.0	5.5	
86°0'	4.73	25.4	6.1	to pt in field =330.5
Set on point in field				H.I. = 1' Lower than formerly
182°		26.3	4.2	by S. fnc.
163°30'		23.9	6.6	" " " ditch
151°15'		27.5	3.0	top knoll by fnc.
138°45'		24.0	6.5	bottom " "
131°30'		26.7	3.8	by fence
86°	620'	21.3	9.2	by brush
86°	430	25.2	5.3	in field
116°	215	21.8	8.7	dead furrow white bnd
100°	175	22.5	8.0	ditch
134°	230			point of knoll
33°20'	250	21.4	9.1	intersection ditches

23°40'	3.65	21.0	9.5
43°40'	4.60	23.6	6.9
57°40	7.00	20.3	10.20
68°14'		24.6	5.9
49°0'	850?	17.5	13.0
39°		22.1	8.4
30°15'	8.20	17.3	13.2
19°30'	9.00	16.9	13.6
19°30'	8.00	22.5	8.0
14°30'	6.50	20.5	10.0
359°	7.70	22.8	7.7
341°20'	8.50	21.2	9.3
333°10'		20.0	10.50
358°30'			
339°45			
333°0'			
330°32'			
329°05			
312°45'			
311°10'			
309 05			
292°0'			

H.I. 23.7 By M.H. race 0.5 above 5.2

ditch
good soil

& RR ring gate
by brush & 200' long
" RR fac
Low spot or ditch

at highway
SE cor old barn
SW " Lincoln School
NW Cor Mrs Hinds House eaves 2 above yard
" " Days " 1 above top bas wall
" " Briers
" " Atwood 1 below top bas. wall
" " Ayers
" " Larsens 330.5 ground between
Top garage SE corn house
6" below porch level Darnells Yard
Mail box white arc .7 deep
Roadway 12.9 W.L. = 21.6 race