33

C.S. 77

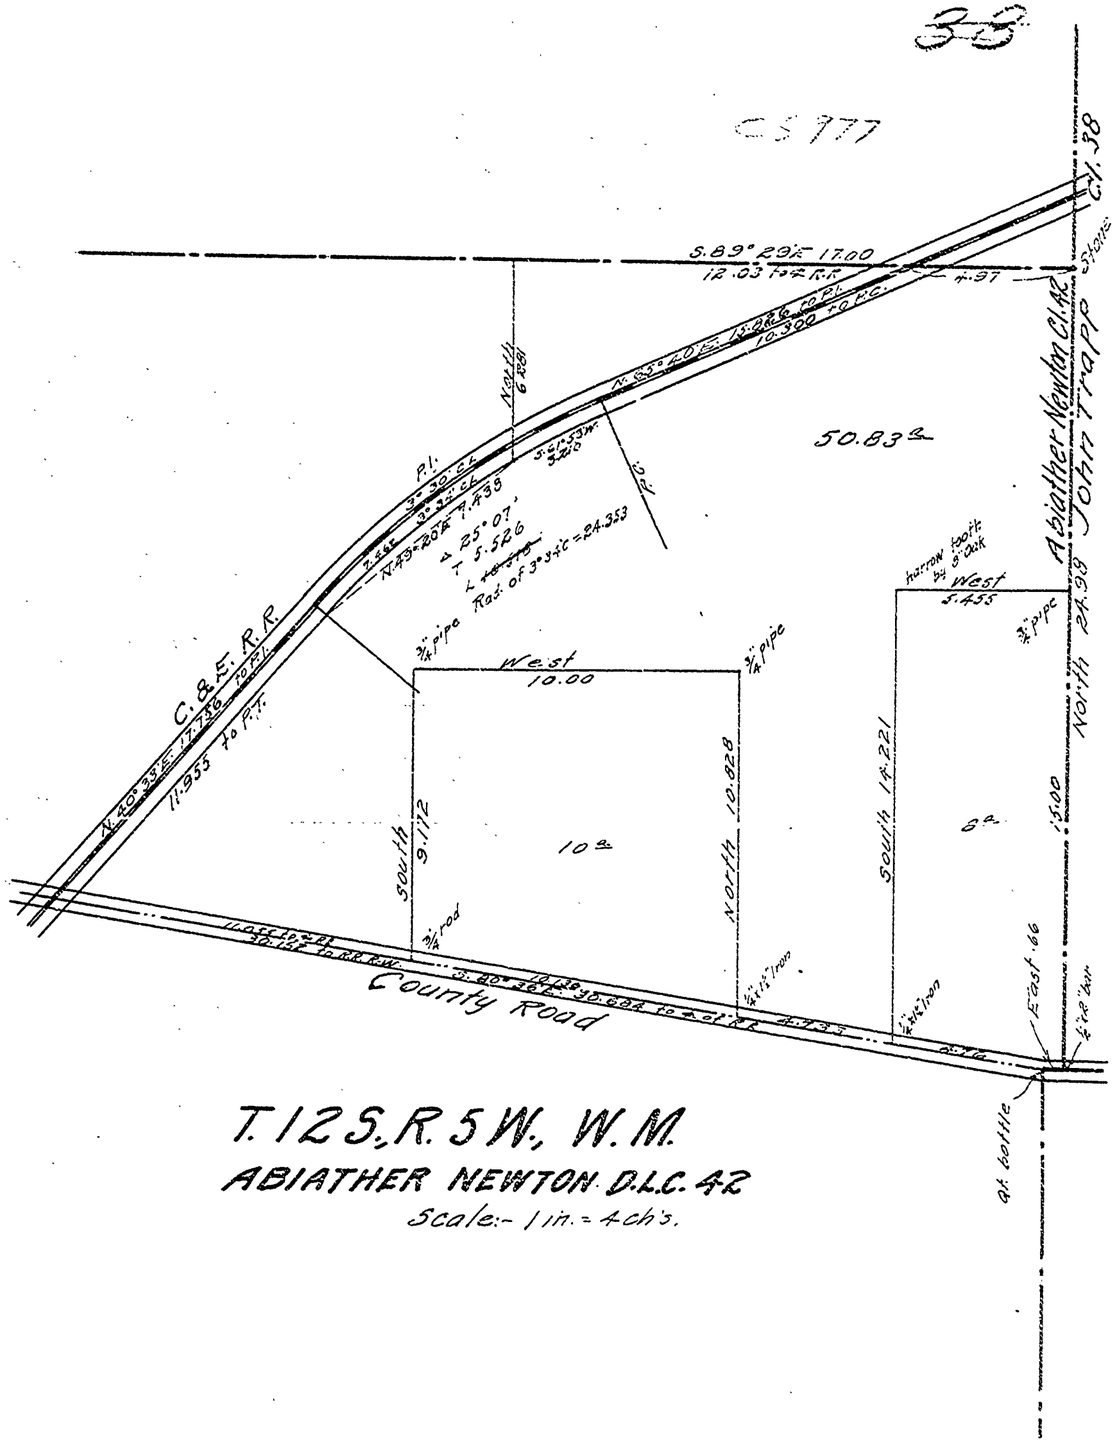

T. 12 S., R. 5 W., W. M.

ABIATHER NEWTON D.L.C. 42

Scale:- 1 in. = 4 ch's.

Miscellaneous

C.S. 977

F/B 35, PG 59-60

Survey for Downer

Began at a bottle, the Int. Cor. of Abiather Newton & Robt. Newton on Road & King's Sign

		N80°36'W	
		9°32'L	
.660		N89°52'E	
		88°41'L	Cl. Cor.
+7°20' 4.930	4.890	N1°11'E	
		0°45'L	Set .100 W.
5° 4.996	4.996		
			Set .138 W.
-6° 3.823	3.802		
			Set .166 N.
-9° 5.000	4.938		fence +1.33 Set .176 W.
1.633	1.633		3/4" pipe
4.121	4.721	24.980	pse S 70° W 2.60
		90°01'L	
.250			

⊙ on Stone N.E. cor. of Cl. 42

Back to △

		90°26'L
-5°40' 4.599	4.576	
	.879	

Set harrow tooth on W side of 8" Oak

59

T. 12 S. R. 5 W.

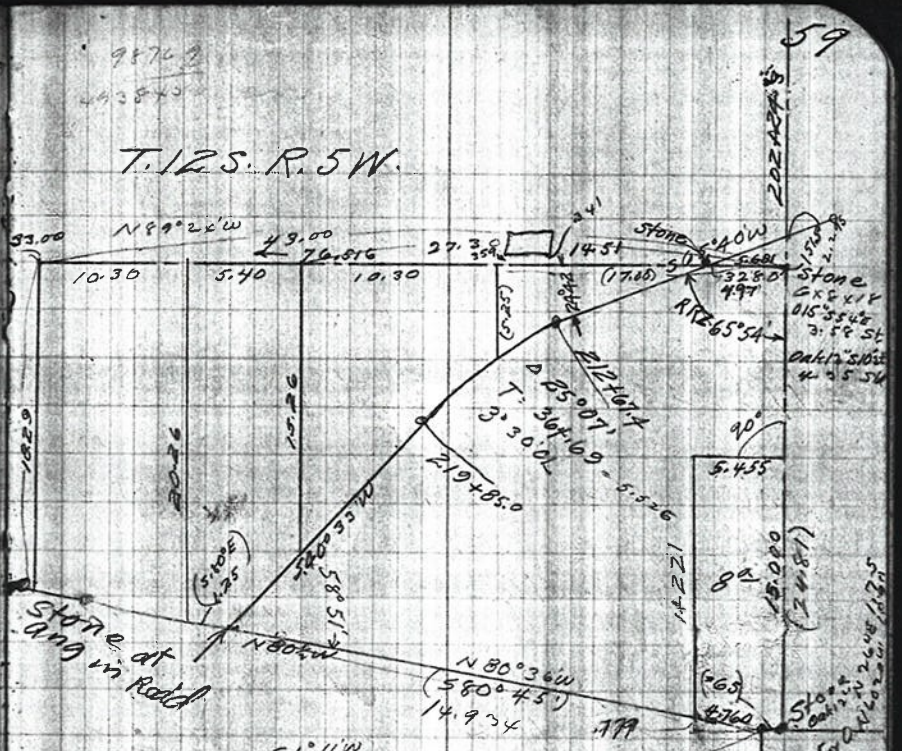

4.784	4.760			
4.770	4.733			
Δ		80°36R		
5.000				
5.828				
Δ		90°L		
10.00				
Δ				
		90°L		
9.172				
		80°36R		
11.013				
Δ		58°51	to RR tan	

10.828
9.172

4.784 − 5.40
713 − 1.40
4.071 − .01

TL = 713 at 4.071 set hardwood tack

Set 1/2" x 1 1/2" iron

Set 1/4" x 1 1/2" iron Browns SE Cor

Set 3/4" pipe

Set 3/4" pipe

E Rail of RR = N40°33'E

S80°36'E
58 51
139-27 = N40°33'E

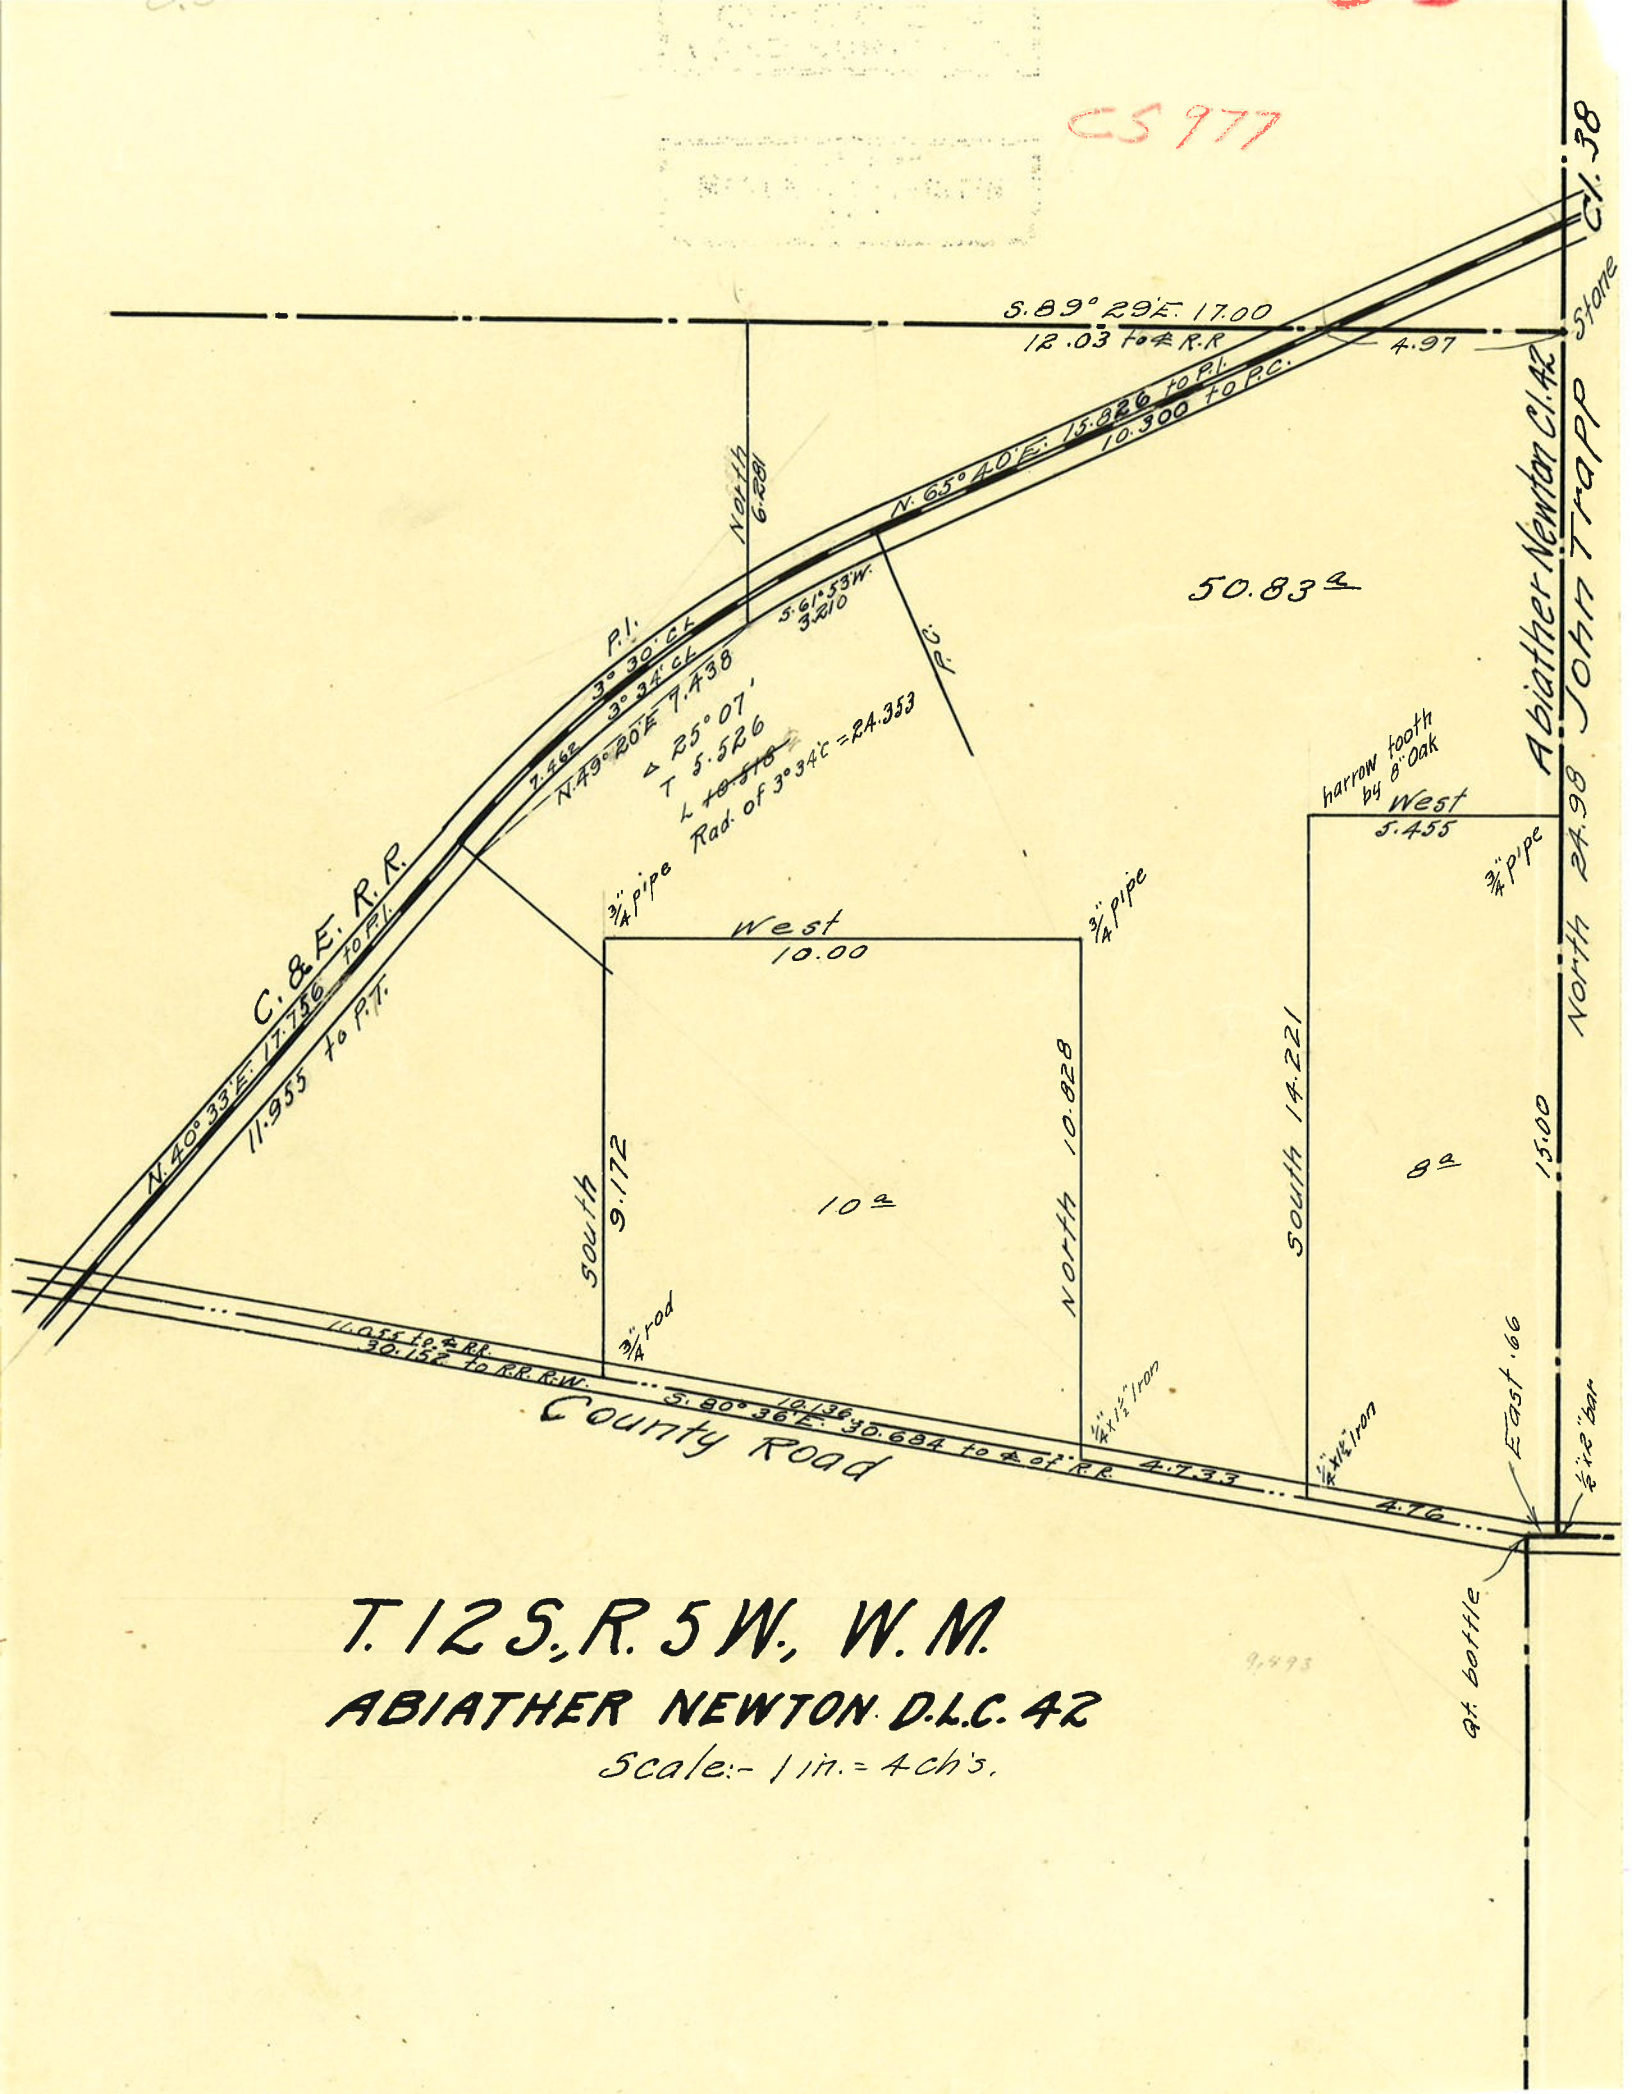

T. 12 S., R. 5 W., W. M.

ABIATHER NEWTON D.L.C. 42

Scale:- 1 in. = 4 ch's.