C.S. # 982

Hardcopy 15-5 # 4

also see notes in file

F. B. 35-74

F/B # 35, PG. 73

982

C.S. 226 Con

Survey for Hollingsworth

Beg at ¼ corner betw

Sec 33 & 4 T14&15S R5W

Run E 1.00 - S0°01'W 2.73

+4015		
4.850	4.837	
4.860	4.860	East
4.860	4.860	
3.743	3.743	
31	18.290	

18.378
1.00
17.378
.108

T. 14 & 15 S R 5 W. 74
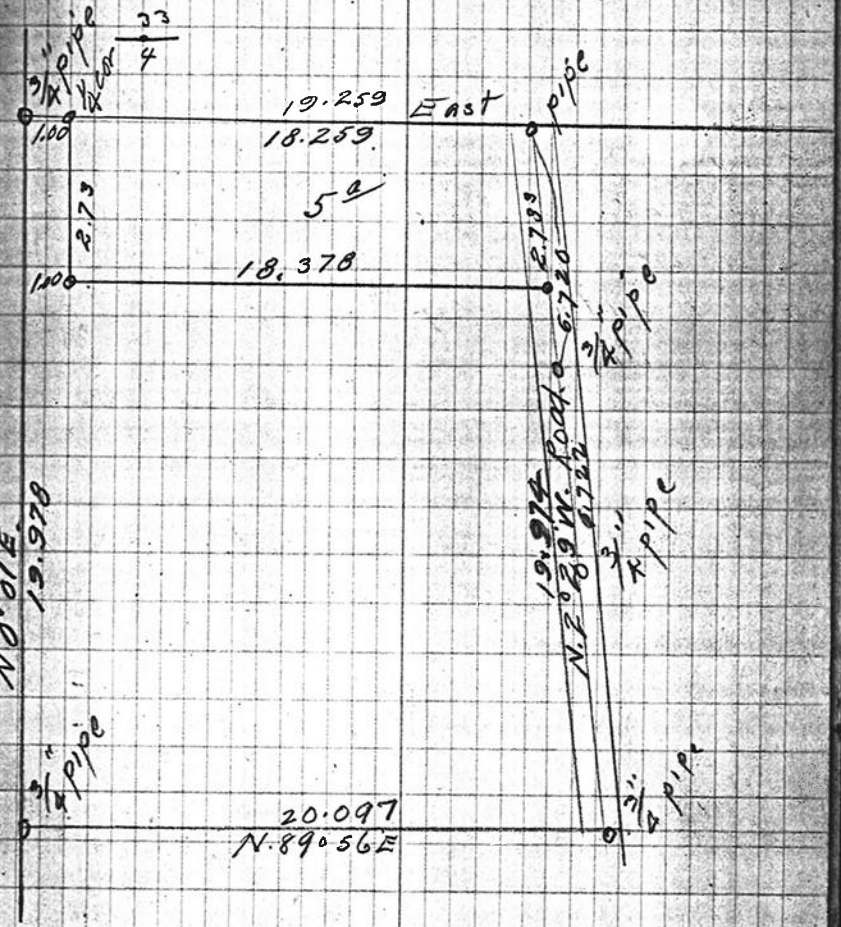
South of Monroe ½ Mile