C.S. # 984

Hardcopy 10-4 #6

also see notes in file

F. B. 35-76

9841 McQuin C.S. 984 F/B # 35, Pg. 76-77

T. C.S. 262

A. Set on point .089 S. of 1" pipe at fence cor.

4.86
4.862
4.862

Tot ang. 92, 14.584

B Set on point .04 S. W of cr S.W.

4.860
4.860
4.860

N13° 33' W 26.770 14.580

0°13'R

4.860

0 0°52'R .014 E

4.860 0°25'R .073 W

2.470 3/4" pipe .018 W set .171 E

Back to point .02 A S. of A B

76°14'L

Tot ang

4.860 0°45'R. S89°43'E Correct 50" B' = S89°37'E

4.660 0°25'L .061 S.

4.860

0°52'L .035

1464 C.L. cor. .021

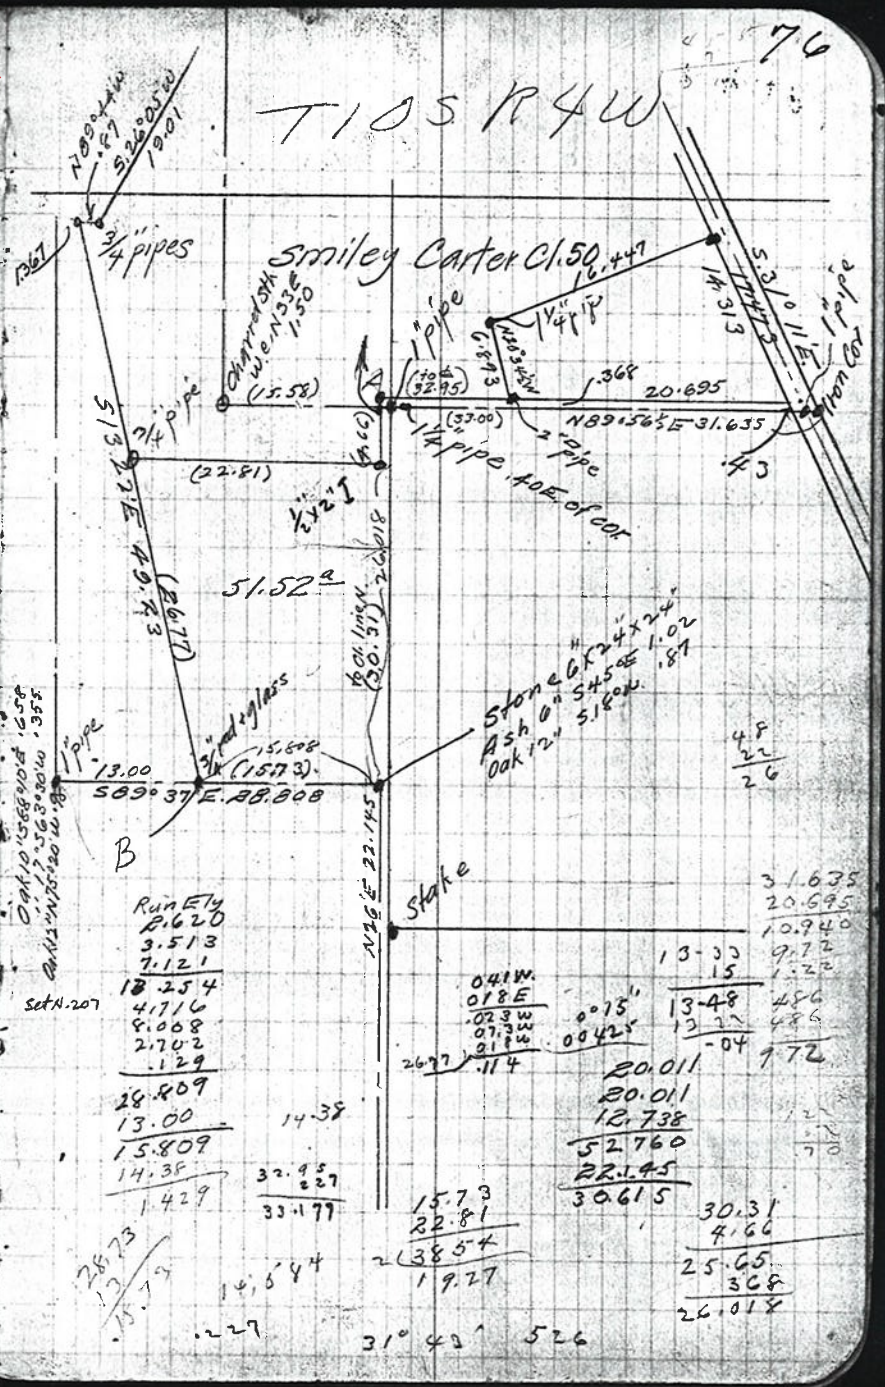

4.
4.570
4.860
9.43

4.860 X 5
2.30
4.394

tot az.
87°27'R
S2°16'E.
Back to Cl. 65
B.S. W
Tot az.
89°27'
8945'R
N0°32'E

set .446E
.352
15
233
248

set .407E
630

12½ hr
31
15.60

S. 89° 37'E
16
S 89° 43'
76° 14'
S 13 29 E
15
13 44
13 22
0° 22'

set .171E

5.89°43E
87° 27'
S 2° 16 E

2° 48'
.0.4885 X 9.43 = 46

3090
30.994
9.43
40424

S. = 0°06
.00185
15.844) 079

4.66
4.394
.266
4

.073

S 89° 43 E
89 45'
179 28
N0° 32'E.

S 13° 33 E
76° 14'
S 89 47 E.

.40W
46E
40.424) .06E
.046
.446

S .024
S .061
.085
N .035
S .050
4.860 N 021
5 S.029

14.300
2.30
26.60
4.394
30.994
.368
30.626

30.994
9.43
40424
364
40.056

0° 05'
(.00148
1
40) 0.00