985

985

BLOCK 11
WELLS & McELROY'S ADDITION
TO CORVALLIS, BENTON CO., ORE.

Scale:- 1 in. = 50 ft. Jan. 15, 1926

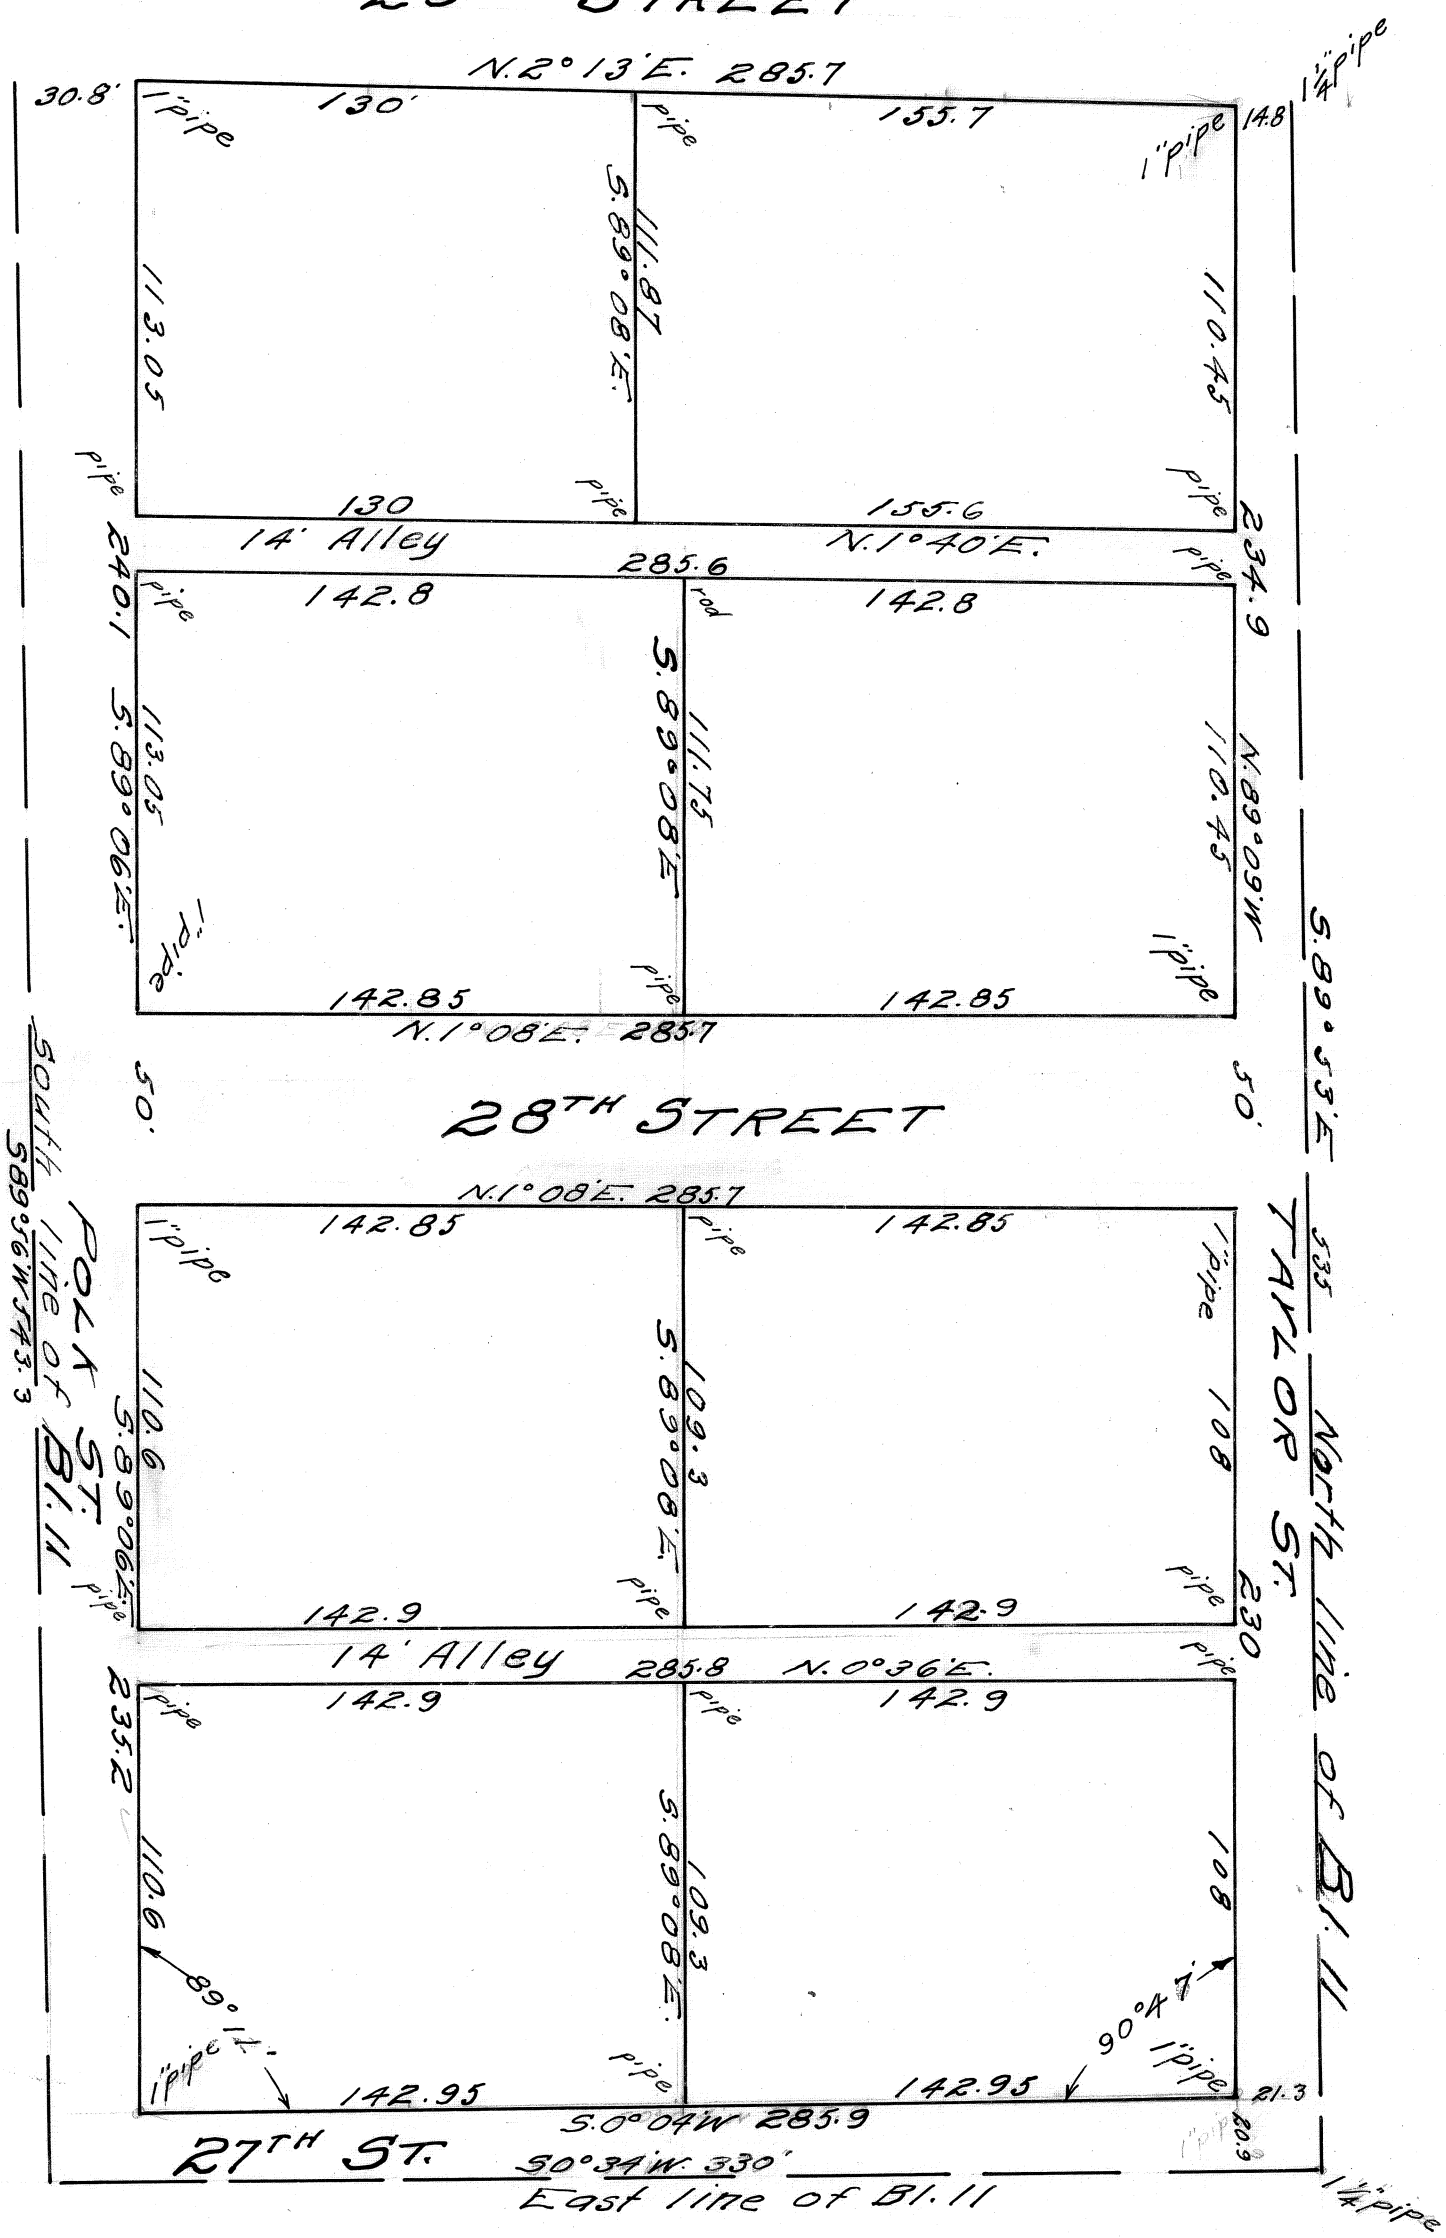

985