C.S. # 991

Hardcopy City Plat #11

also see notes in file

F. B. 36-10

COAST

FIELD BOOK

No. 36

36

10

991

Alpha Rho Sorority

Madison St

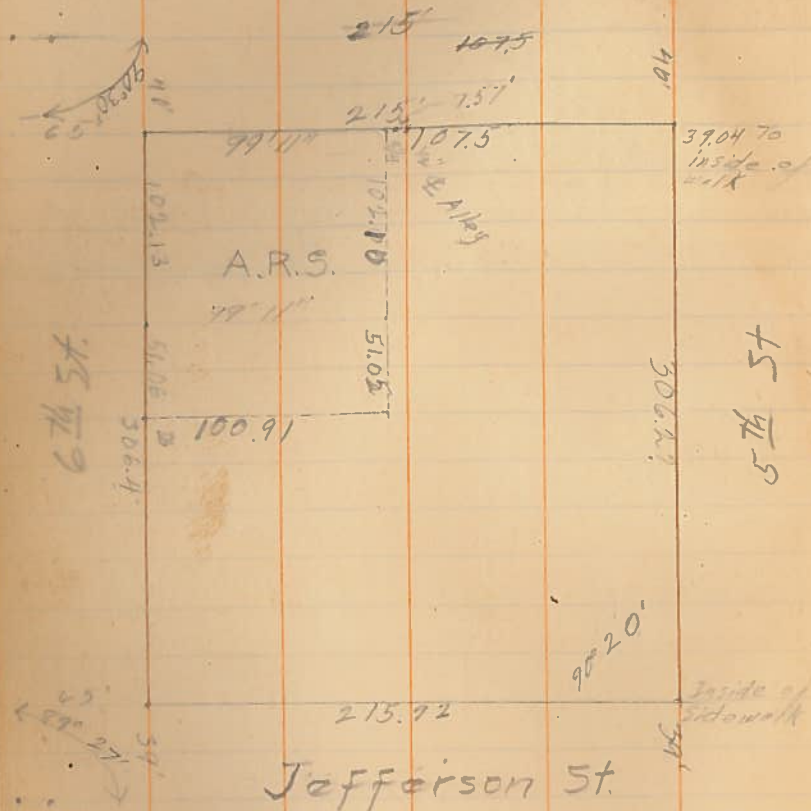

June 1, 1926
Arthur Bester assistant

Sec 35-11-5

3|3064
102.13
.03
2|102.90

215.92
.14
2|2019 2
100.91

215.92
21.92
.46