993

BLOCK 33

~~Wells & McElroy's~~ ADDITION

CITY OF Corvallis

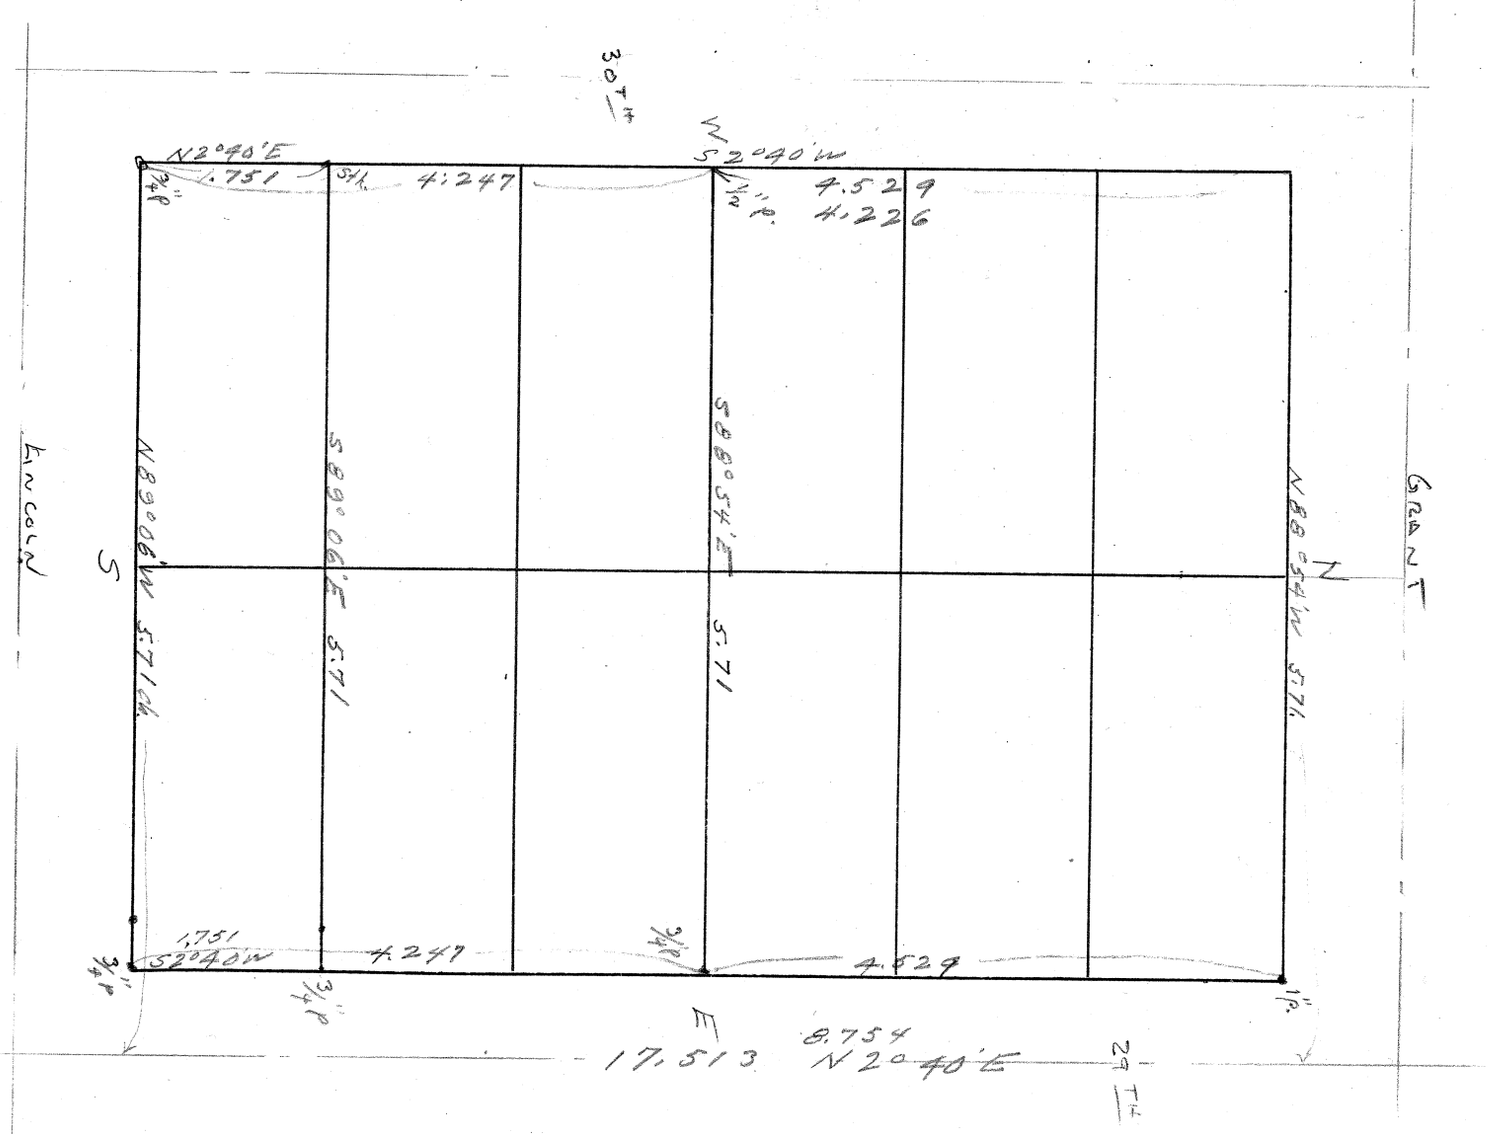

72