C.S. # 996

Hardcopy 13-5 # 2

also see notes in file

F. B. 35-35

996

C.S. 131 A con.

For F.S. Payne May 14. 1926

CS. 996 F/B 35, Pg 35-36

Seton E side pavement

S. Line 34-12-5 N 89°47½ E — sight down fac line — Baker Ct. 94°30 int. ang

4.501 N 4°17 E

0°14½ R

70.00 N 4°31½ E

2.68 77.181 + .043 = 77.224

85°03 L int ang to ℄ Road E

(+ 38.581 94°20 should be USGS .118 N .161 N — fac line 11 N

set .043 S.

△ Back to pt 19.291 S. of car

Run East True at .333 E of E side of pav. set stk.

27.902

△

5.000 0°17 L

△

4.780 0°10 R .024

△

3.455 set .014 S .010

△

2.248 set .007 S .007

2.746 set .001 N .008

0°10 L = 00

3.770

49.901

.121

50.022

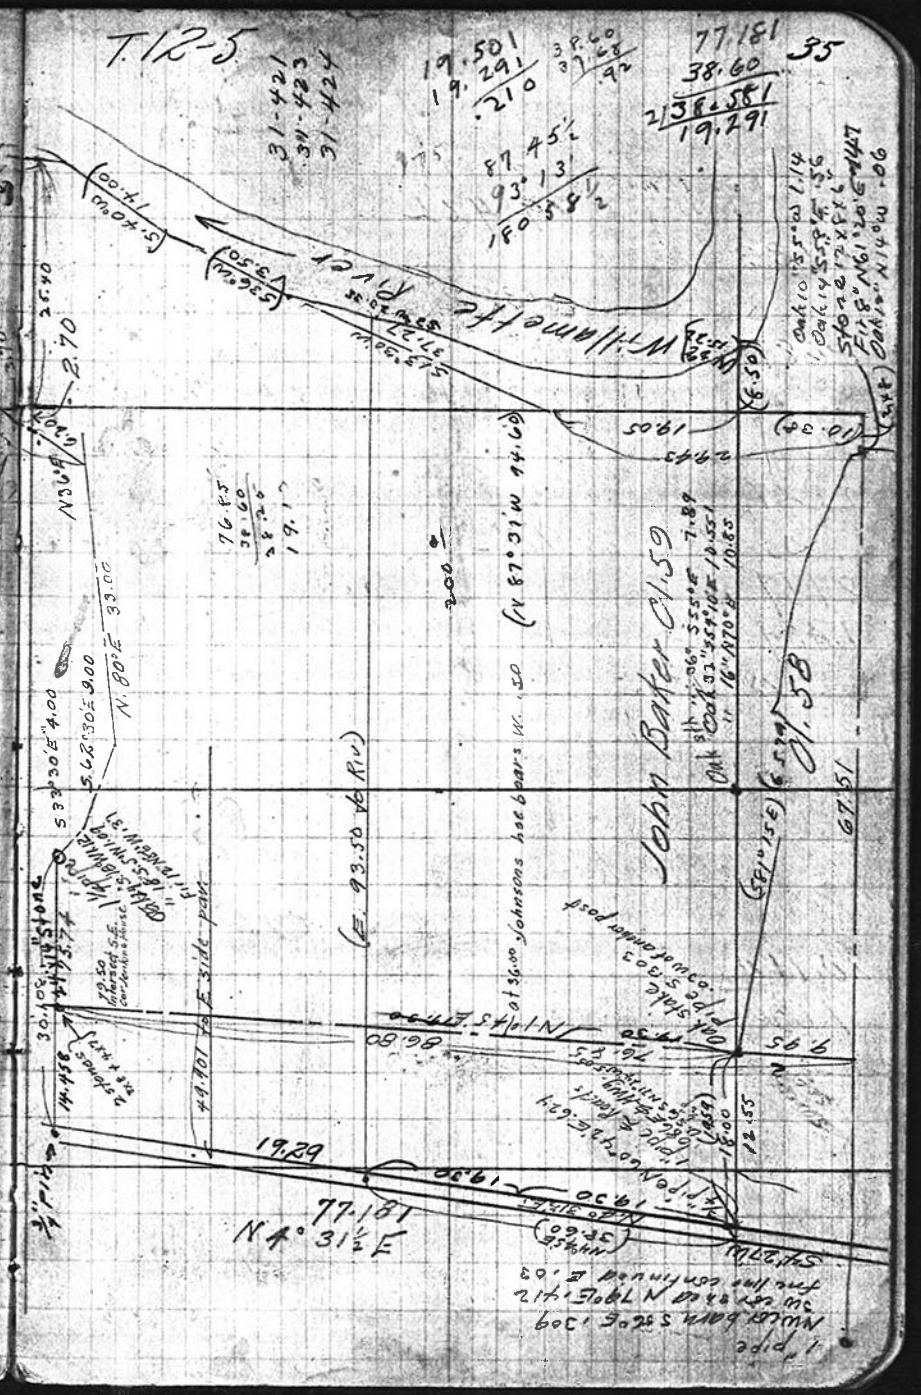
T. 12-5
Wentworth
John Baker Ct. 59
Ct. 58
Ct. 57
N 4° 31½ E
77.181
19.29
Johnsons bar bears S. W. 1.00
(E. 93.50 to Piv)
Oak 33" 36" 55°
Oak 33" 44" 10"
Oak 16" N 70° E
Oak 10" 55° E
Oak 10" 55° E
Oak 10" 55

3.123
2.687
3.176
10.247
19.233

89°42'L

3.123

Δ

0°32'R Set 016 W. .016

2.687

Δ

0°32'L Set .009 E .025

3.176

10.247 19.233 + .043 = 19.276

Δ

90°L Set 1½" pipe .0435

8.177
1.459

Δ 9.636

+90 W. side Lake 2.00 wide

Back to R." pipe 8.45 E to brk
+90 ±

10.110 ΔT
1.130

Δ

Oak 10" N 50°W .16
" 6" N 50°E .085
" 8" S 20°E .136
at 4.60 N .1°W 1.50 to N. shore 3.00 wide
N 3½°E 2.00 .40 E to " " 3.50 "
N 2°W 5.00 1.60 E " " 4.00

+ 6.308 Set 1¼" pipe + 1.0 ± slough
Bears W. to orig line S 80°E
on N. side of roadway

Sta T+500 +40°R — 7.916
Lake pt. 1.50 + 3.02 + .60

N50°18'W N87°10'W N85°18'W
1.40 L 36°52'L 2.215 1°52'R 7.94 L
94°42'L .488 South To pt 500 N of T.