C.S. # 997

Hardcopy 11-7 # 16

also see notes in file

F. B. 36-5

3 997 F/B # 36, Pg. 3 #5-8 Sept 15, 1924. For W. L. Graham
John Harmson Helped

Rec'st. C.S. 87 Continued

30+29 T 11-7

Set Fir pitch stake See Book 31-P. 32

Mkd. Maple 8" S. 51°15' W. .562

" Fir 34" N 68°20' W. 1.084

West (S. 89°22½' W.) Correction S. 47½'

Needle bearing

		-14°15'	4.973	S.067
1				
		-23°04'	2.801	S.103
2				
		-21°54'	5.423	S.173
3			.145	
4			7.022	S.175
5	Set over S. .008 and Backsighted to △2 makes ∠ of 7' to △2 from △5 then continued parallel to line			S.176
		-10°	4.710	
6				S. .293 S.231
		+6°40'	4.469	
7			-1.622	
			#S. .271	
	Set a Pitch fir Stake			
	Fir 24" N. 41°30' E. .127 cks			
	" 20" S. 84° E. .276 "			
			1.352	
8				S.312
9		-13°04'	5.077	S.389
10	∠ Left 52'	-13°45'	4.632	Offset .085 S.
		-13°15'	1.124	S.384
11		-17°45'	2.569	S.418
12	Continued to Page 5			

271
137
.134

.9563 .941 .90000 86067 39330 38252 1078

-10° .98481 73435 393924 295443 689367 722850 1622 723 899

2 | 40.102 20.051 1.622

4.820 2.597 5.032 .145 .022 4.638 4.439 21.673 1.352 4.946 4.499 1.094 2.447 36.018

.97336 1.124 389352 194676 97338 97335 9407912 4.632 194268 291402 582804 388536 4199246880

.5593 .3151 .5593 .2796 .2795 16 .08460

.9524 2.549 857164 571443 476220 190488 24467156

5

C.S. 87 Continued from Page 3

C.S. For W.L. Graham

13			-.111	
14	∠ Left 30'		2.452	
			+1.750	=40.102 on line
15				40.106 at Center
			S.451	
3/0	Set 1¼" pipe	+15°50'	W.144	Will be stumps
	Fir 36" S. 26°30' W.	.884		
	" 34" N. 37°38'	1.301		
15			3.828	
16		+C°	7.997	
17		+29°35'	7.806	
18		+22°24'	.894	
19		+5°30'	1.326	
			+1.046	
	Set 1¼" pipe	& S. of Ft.	.720	
	Fir 30" S. 52°	W.	.103	
	Fir 20" S. 14°	E	.131	
20	∠ R. 45½'	-10°50'	5.824	
21	Parallel		2.243	
22		-6°55'	4.413	
23		-2°10'	5.259	
24			.745	
	Re est.			
	∠ Left 46°40'	-4°50'	1.451	
25/30	Set 3¼" pipe in roots of a Lirt ground			
	Cedar Stump mkd. ¼ S. B.T.		N 24°E	1.30
	" tree	two blazes	N. 29°W.	1.30
	Fir 38" N. 73° W.		.287 cks	
	" 40" N. 28° W.		.060 "	

Witnesses
W.L. Graham
Otto Popke

6

May 25, 1926.

Back To △ 14

Set 25	West		1.606	
			+.148	at Transitline
				+.144 at .951 S.
	North correction 27½ W.			
	(N. 0° 27½ W.)	-1° 30'	3.717	
26		+4° 30'	3.736	
27				offset
28	∠ R. 28'	+9° 15'	6.210	.050 E.
29	Parallel	+2° 35	4.774	
30		-1° 30'	4.304	
31		+7°	1.617	
32		+2° 30'	2.491	
33		-1° 10'	3.913	
34		-3° 55	3.910	
35	∠ Left 8° 34½'	-15° 42'	6.214	offset .892 N.
36	∠ Left or S.E. 24° 30'		.906	to ¼ S. offset
	From △ 35 N. 0° 45' E.	To 40	cor. 3.76 E.	
Exp 36	N. 0° 22' W.	to cor.	20.00 N.	

Back to △ 25 ~~30~~

	South correction E 27½'			
	∠ Right 12'		.404	
		+28° 48'	4.215	
		+11°	.356	offset .016 N.
37		+	.414	
38				
39		-14° 10'	6.812	
40		-16° 14'	2.236	

(Survey 87 is N. 20' W. in Sec. 19)

.451			
3.716			
3.724			
6.129			
4.769			
4.302			
1.605			
2.489			
3.912			
3.901			
5.915			
40.923			
.824			
40.089			
39.257			
79.346			

.404			
3.694			
.349			
4.447			
.451			
3.996			
6.605			
2.147			
12.748			

4.447	Offsets	.00394 = 27½ E	
.00349	going S.	79346	.63
4.0023			46
1.1788	.376 W.		
1.3341	.892 E.		.466 W.
1.552003	.516 E.		.318 E.
	.050 W.		.148 N. △ 25
	.466 E.		.312 E.
	.016 W.		.164 E.
	.450 E.		.016 E.
	.032 W.		.032 E.
	.418 E.		.072 E.
	.011 E.		.018 E.
	.429 E.		.302 E.
	.072 W.		.011 N.
	.357 E.		.291 E.
	.018 N.		.291 W.
	.339 E.		.000
	.321 E.		
	.630 E.		

7

				6.377	offset .032 W.
41	∠R. 17'				offset .011 E.
42	∠L. 9'		+1°40'	4.174	2 sets .072 W.
43	∠R. 40'		+28°10'	7.035	
			+25°05'	1.618	
44					
45	∠R. 24'		+13°30'	2.407	offset .018 W.
				.253	
46					
			−6°15'	4.546	
47					
	∠ Left 13°50'			1.216	offset .291 E.

To 1/4S. 1st Set 1½" gal. pipe

Re's Dug for corner but found no print

Cedar 24" S. 20° E. .54 lying down

Burnt Fir 40" N. 5° E. .770 std

" 9" S. 52° W. .084

" 22" S. 89° 30' W. .173

N. 89° 30' E.

Correction S. 34½'

48	(S. 89° 55½' E.) 40.085		+29°34'	1.660	S. .014
49			+15°44'	1.980	
50			+10°	2.105	
51			+3°30'	.966	
52			−7°15'	3.784	
53			+10°50'	3.716	
54			+4°45'	5.084	
				+1.183	∠R. 2°01'
				S. .188	.044
					.188
					.144
					.012
					.156

Fir 34" N. 73°30' W. .288

" 30" N. 10° E. .730

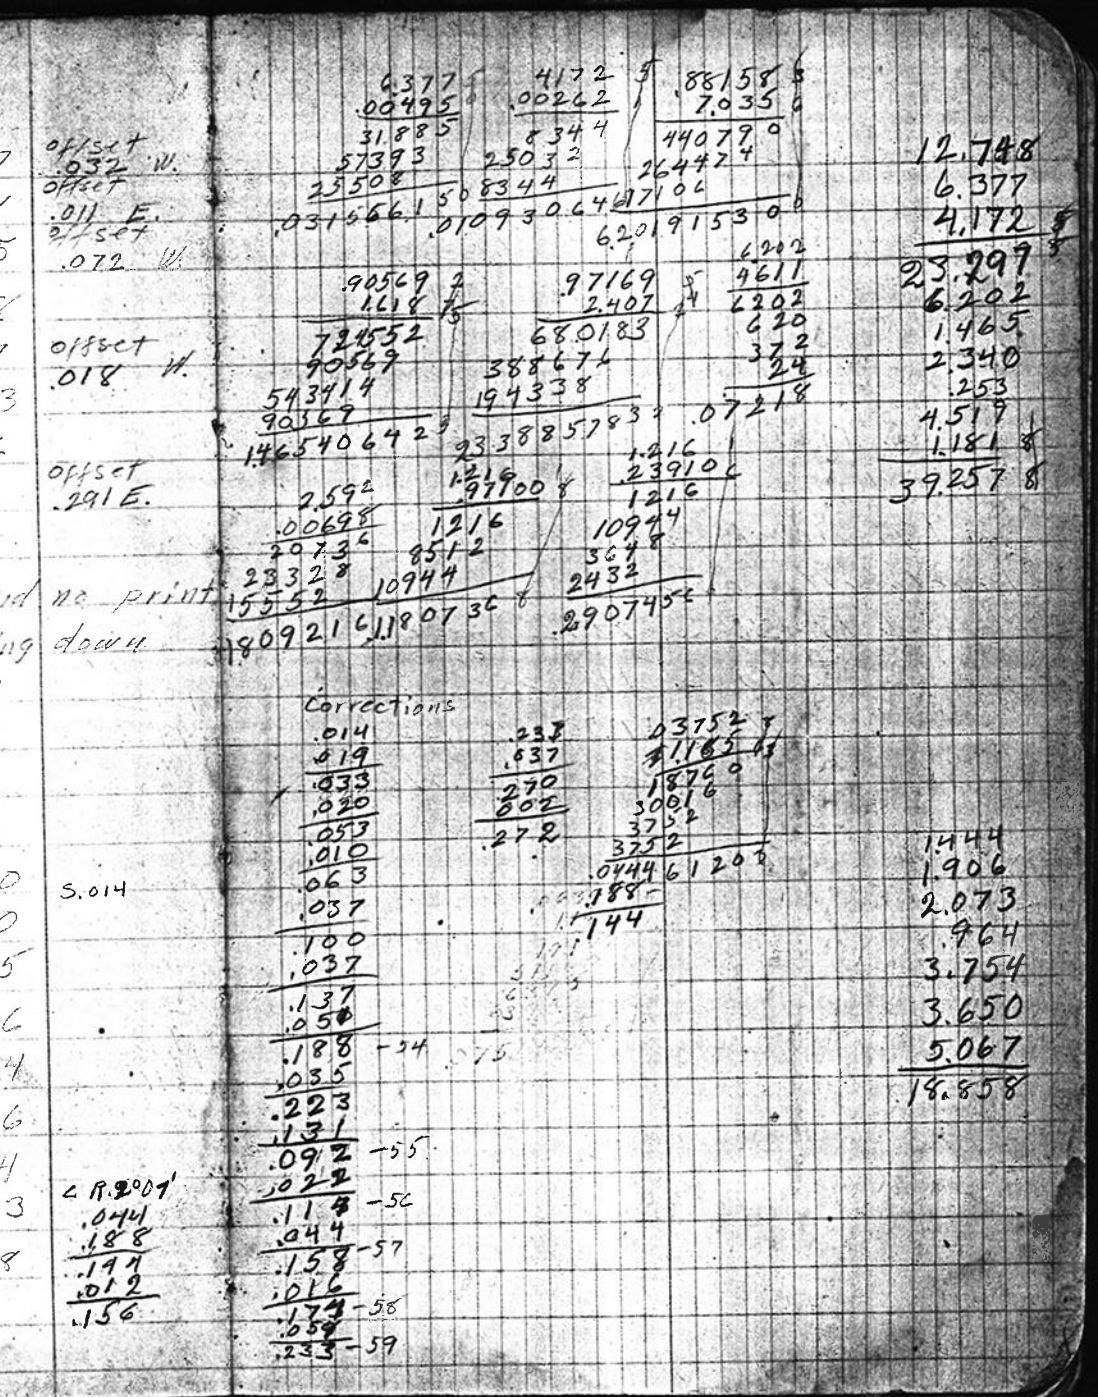

8

55	∠ R.	2°09'	-7°40'	3.536	offset .131 S.
56				2.027	
57				4.427	
58			+9°40'	1.611	
59			+9°33'	5.854	
60			+3°40'	3.685	offset .272 S. To S.E. of Sec. 30
	S. 49°50' E.			.356	

Reest. Set 1" pipe

All Burned firs on found and practically check

Marked Fir 30" S. 73° E. .606 -16° .821 =

" " 15 S. 14° E. .789

" " 7" S. 59°50' W. 1.330

" " 8" N. 28° W. .378

.98580 .98644
1.611 .5854
.98580 .38744
.98580 .49307
.98580 .78912
.59148 .49307
.98580
1.58941 238° 577286 356 #

.64501 .76417
356 356
387006 458502
322505 382085
193503 229251
229623561 272045528

offsets
.131 S.
.272 S.
.403 S.
.00100 5 = 34½'
.40083 .40300
40080
217000

20041 18.858
18.858 3.502
7.183 2.027
.61 4.427
28.814
1.588
5.773
3.678
39.853
.230
2 40.083
20041