C.S. # 999

Hardcopy 12-5 # 17

also see notes in file

F. B. 36-13

13

999

F/B 36, PG 13

C.S. 61 Continued

Stone at N.W. of Prior Scott

Recd. Cl. 44 T-12-5

	Service 16"	S. 65° E.	1113		
	Maple 18"	S. 38½' E.	.965		
	" 24"	S. 23°20' E.	1.302		
	Chittam 14"	S. 22° W.	1.145		
	N.E. Main Cor. of house	S. 37°53' W.	2390 + 2°40' 2.387		
	Fence north, East		.142 To fence		
		+2°	8.000	7.995	
		+1°	8.000	7.999	
1			.790	.790	
				16.784	
2		+1°	8.000	7.999	
3		+4°	7.084	7.067	
			+.030		
			2.389		
			+N.171		
	Set 3/4" pipe on line				
	∠R 1°01'	-5°5'	2.389	2.381	
		-5°40'	6.884	6.852	
			4.116	4.116	
				28.415	

To stone 8" x 10" x ?

CS 999

June 17, 1926.
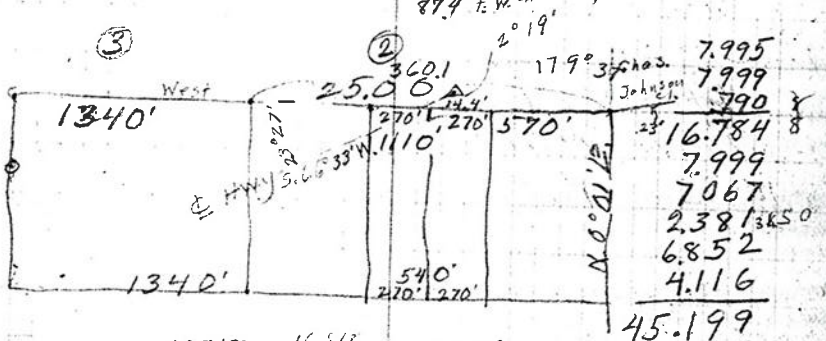
Arthur Custer & Guilford Mack