C.S. 1005

SEE NOTES IN FILE

FIELD BOOK 37, PAGE 7

1005

Survey for Robt Wyse.

Began at A at point on W. R/W of R.R. (1" C.S. 84)

RR S 2° 13 E

on Line		30' S. of ℄ Co.	
400.0		~~N 89° 30 W~~ S 88° 14 E	
660.0	16.061		
△			West side of Cr.
753.0	11.410		
△		½" temp. ctr.	Set 28.1 E 26.5 N
990.9	15.001	N 0° 30 W S 50° 16 E	
△			and 5.3 N 0.8 W of 1¼ pipe
1247.6	18.903 +11	S 89° 45 E	
△			5.3 N of iron rod
298.0	4.515	S 0° 30 W	
38.3	.580	S 0° 30 W	
△ 21.5 △ 127.9	1.938	S 83° 30 E	
△			1" bolt on W. line Hwy
87.3	1.323	"	
△			on W. rail
172.4	2.612	N 4° 0 E	
△			.8 E of W rail N 89° 45 W 55.705
88.4	1.339	N 89° 45 W	long W rail
△			Bear rail ℄ N 2° 10 E
553.4	8.385		¾" pipe 1 iron 2 RR
△			¾" bolt 1.2 W ℄ Cr.
381.4	5.780	N 35° W	

FB# 37

7

T. 11 S R 5 W

Arnold Fuller Ch.

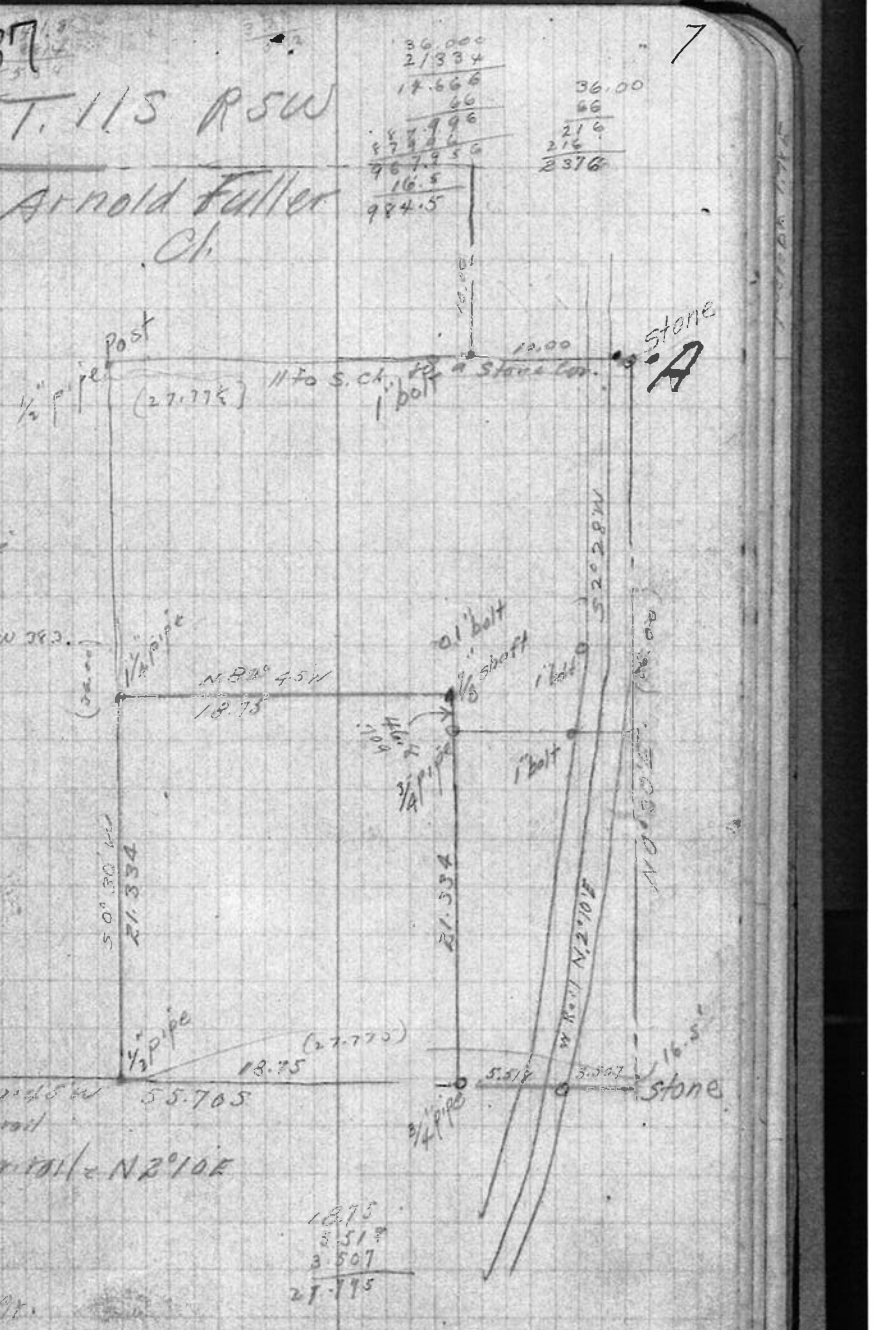

8

N88° 16' W

574.5 8.706 N11°25'W

1.7 .026 S88°22'E

26.5

+2.84 set ½" bolt by fac. temporary

former hub on creek bank

S0°38'E
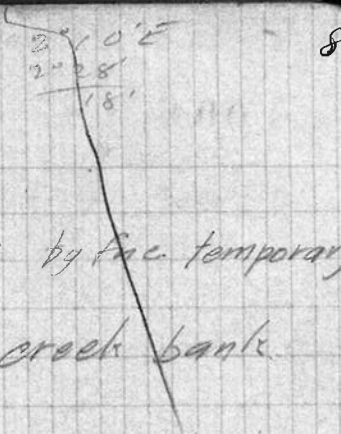
N0°30'W
N0°30'E
1° 0'