C.S. 1006

SEE NOTES IN FILE

FIELD BOOK 37, PAGE 9

FB #37, PG-9 CJL

9

1006 C.S. 352

Survey for Kings Valley High School
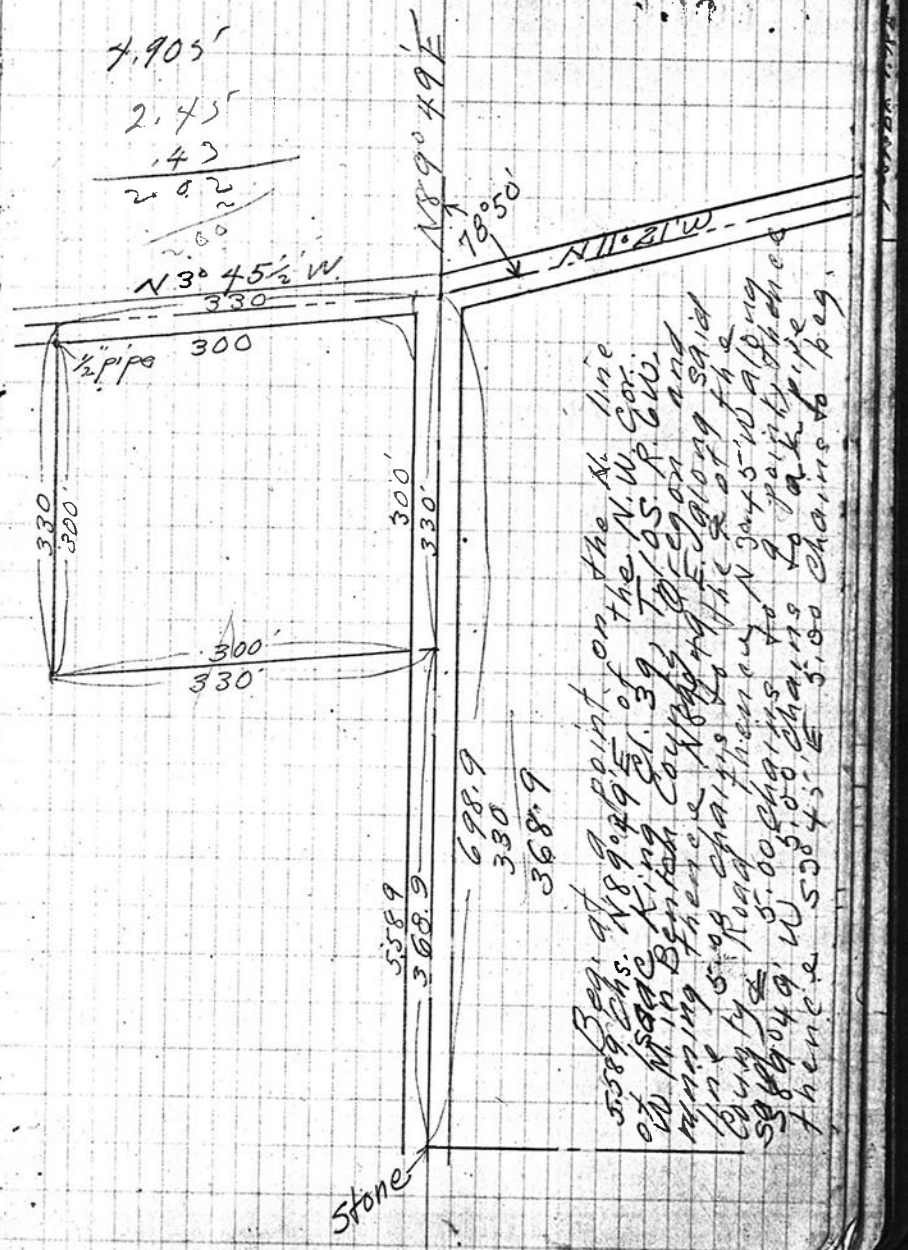
... description changed later.