C.S. 1008

SEE NOTES IN FILE

FIELD BOOK 37, PAGE 14

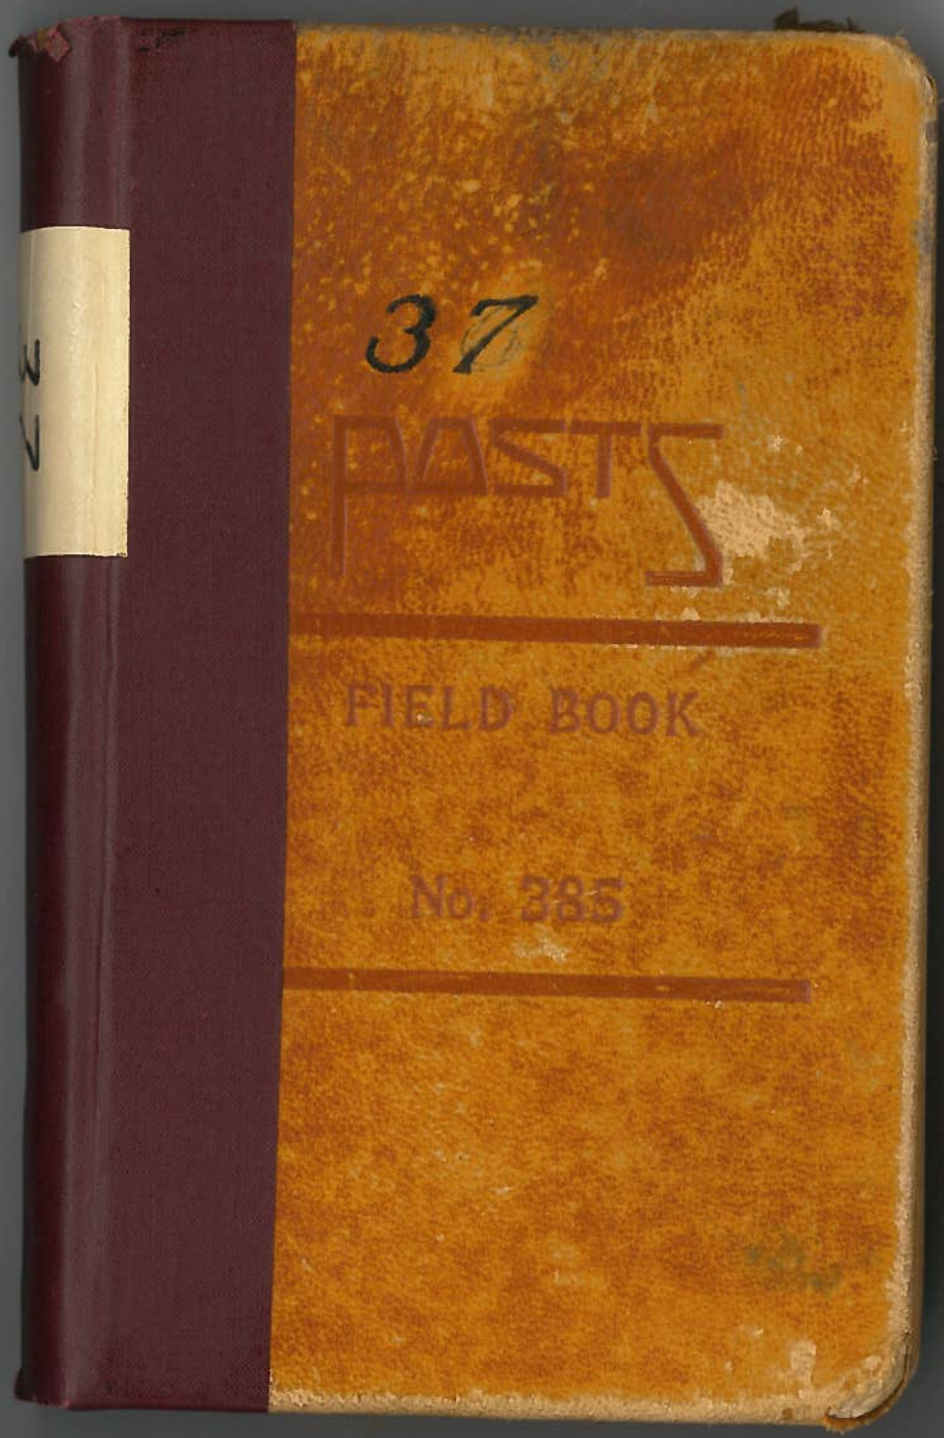
37
PASTS
FIELD BOOK
No. 385

14

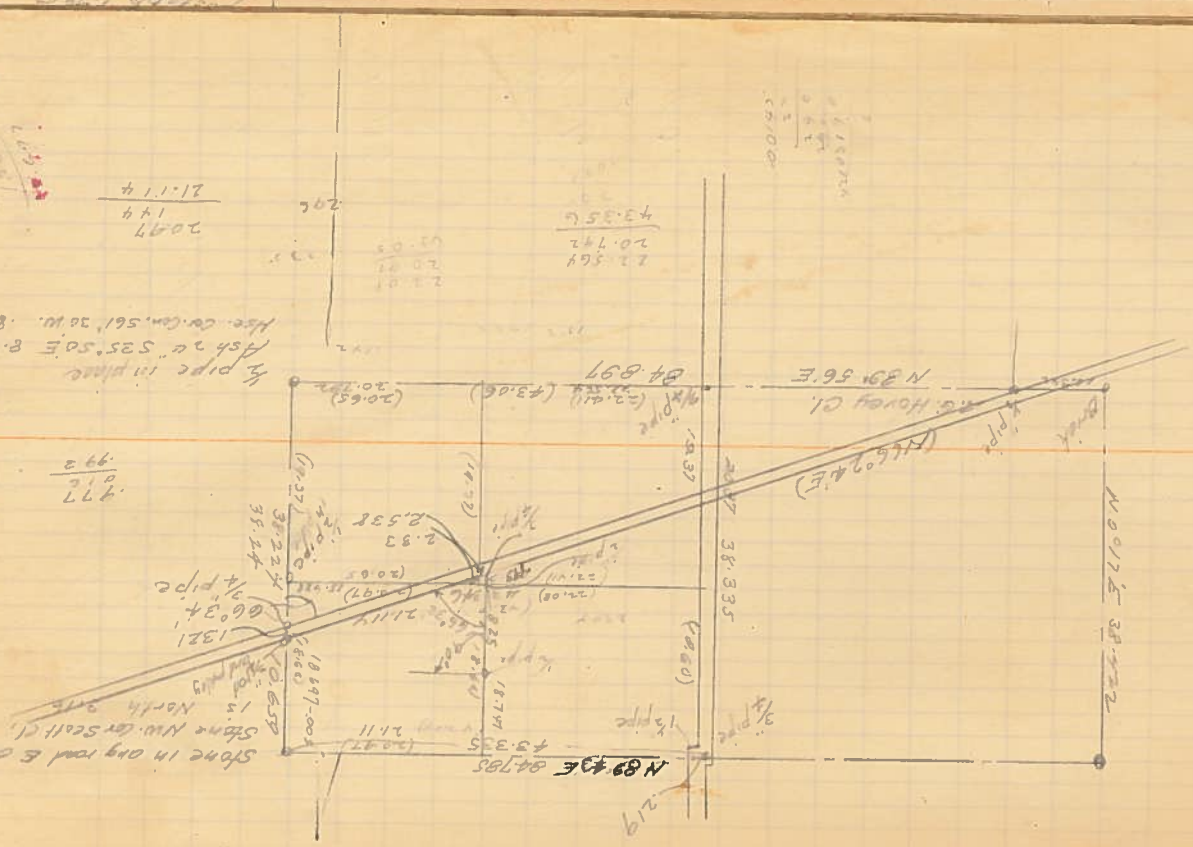
N 89° 56' E
N 0° 17' E
38.33
Stone in orig road E of hwy
Stone NW. cor. Scott Cl.
North 3rd
Ash 12" S 35° 50' E 8.28
Mag. Co. Com. 561' 30" W. 821

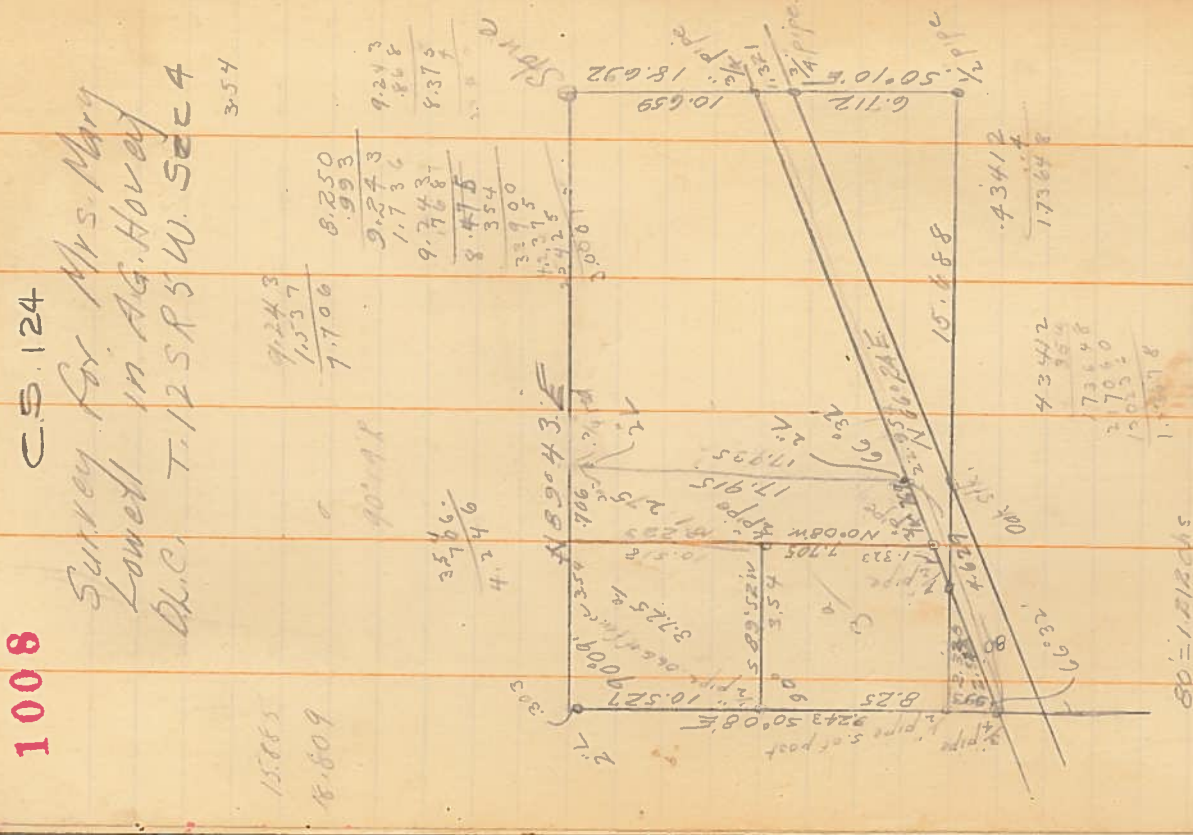
1008
C.S. 124
Survey for Mrs. Mary
Lowell in Ag. Hovey
T. 12 S R 5 W. Sec 4
N 89° 56' E
N 0° 08' W
S 0° 10' E
S 89° 43' E
S 0° 08' E
10.639
18.692
15.488
10.527
8.25
17.915
3.54
3.125
80.00
80 = 1.212 chs
N 66° 02' = 1.321