C.S. 1009

SEE NOTES IN FILE

FIELD BOOK 37, PAGE 15

1009 C.S. 180 F/B #37, Pg. 15

Survey for Albert Zierolf
in Aaron Richardson Cl. 44
T. 14 S R 5 W. - Began at A.

12.888
12.54
Δ
1.016
Δ
22
13.652
8.348
Δ
7.40
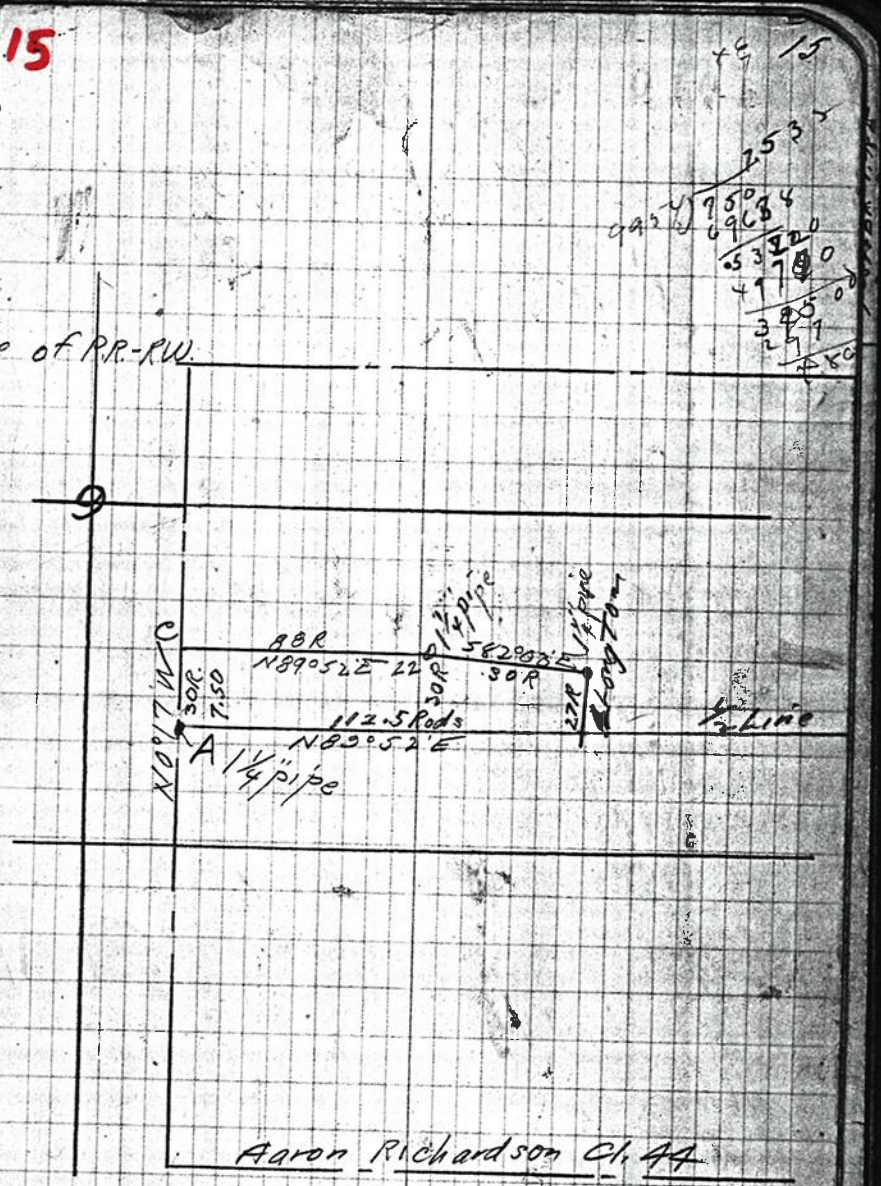
W rail N89°52E
Set 1" rod on E. line of R.R. R/W.
W side of R/W
N end Br. set ¾" rod