C.S. 1010

SEE NOTES IN FILE

FIELD BOOK 37, PAGE 16

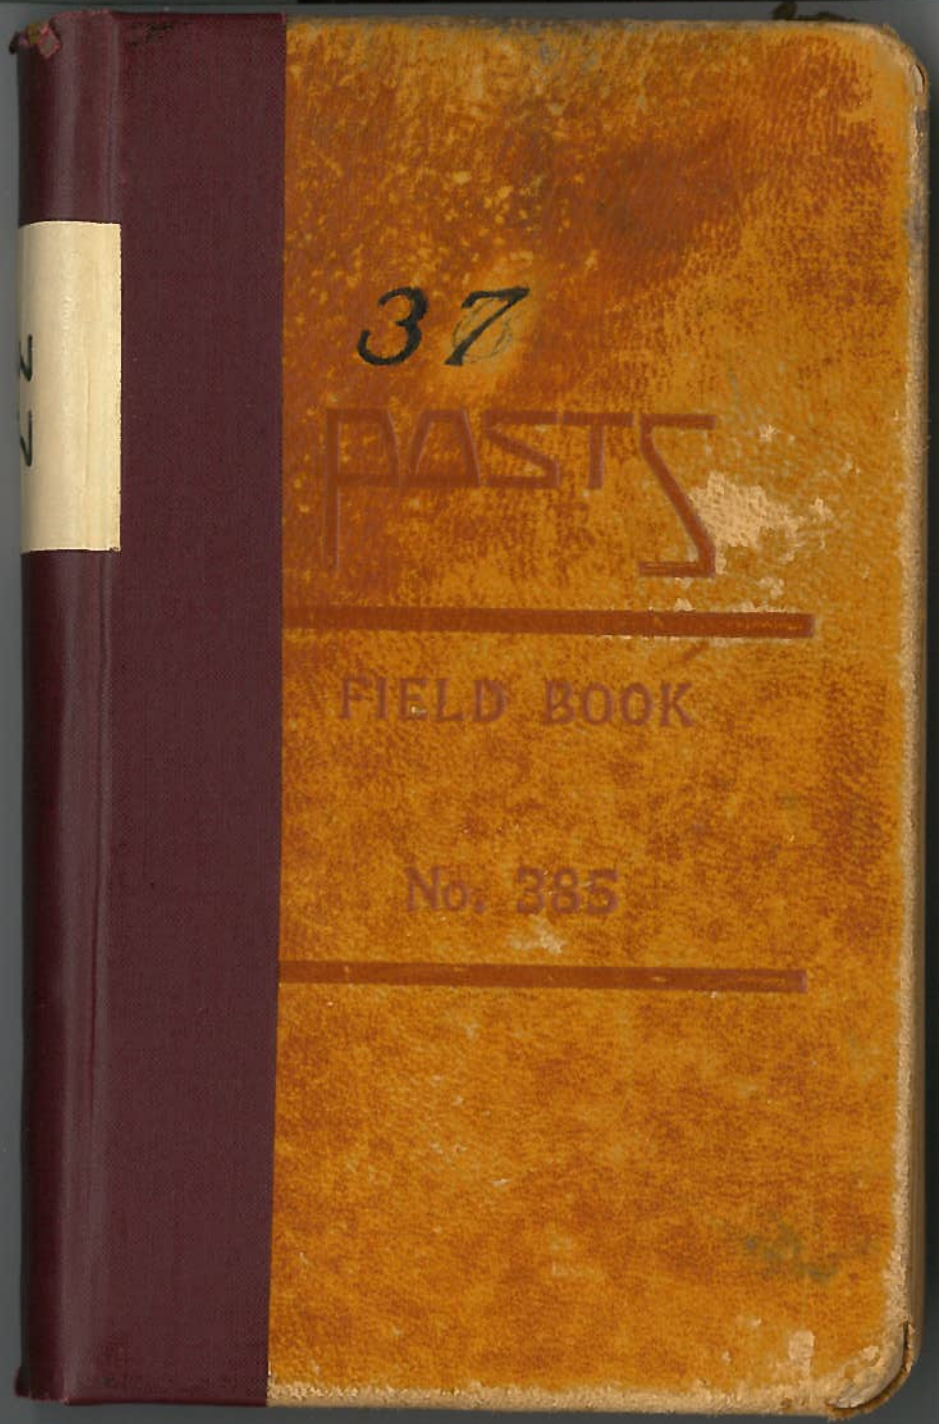
37
PASTA
FIELD BOOK
No. 385

1010

16

Stadia Survey for
Byron Taylor. N. 2nd St.
Corvallis Sec. 35-11-5

Set on W. side pavement
on ℄ ditch Tot. "E" S. N. on pav
78.11L

-7°30'		
1.15	52°30'L	N19½°W
1.18		N6°E
2.15		N8°30'W
4.30	NE on Or	