C.S. 1011

SEE NOTES IN FILE

FIELD BOOK 37, PAGE 17

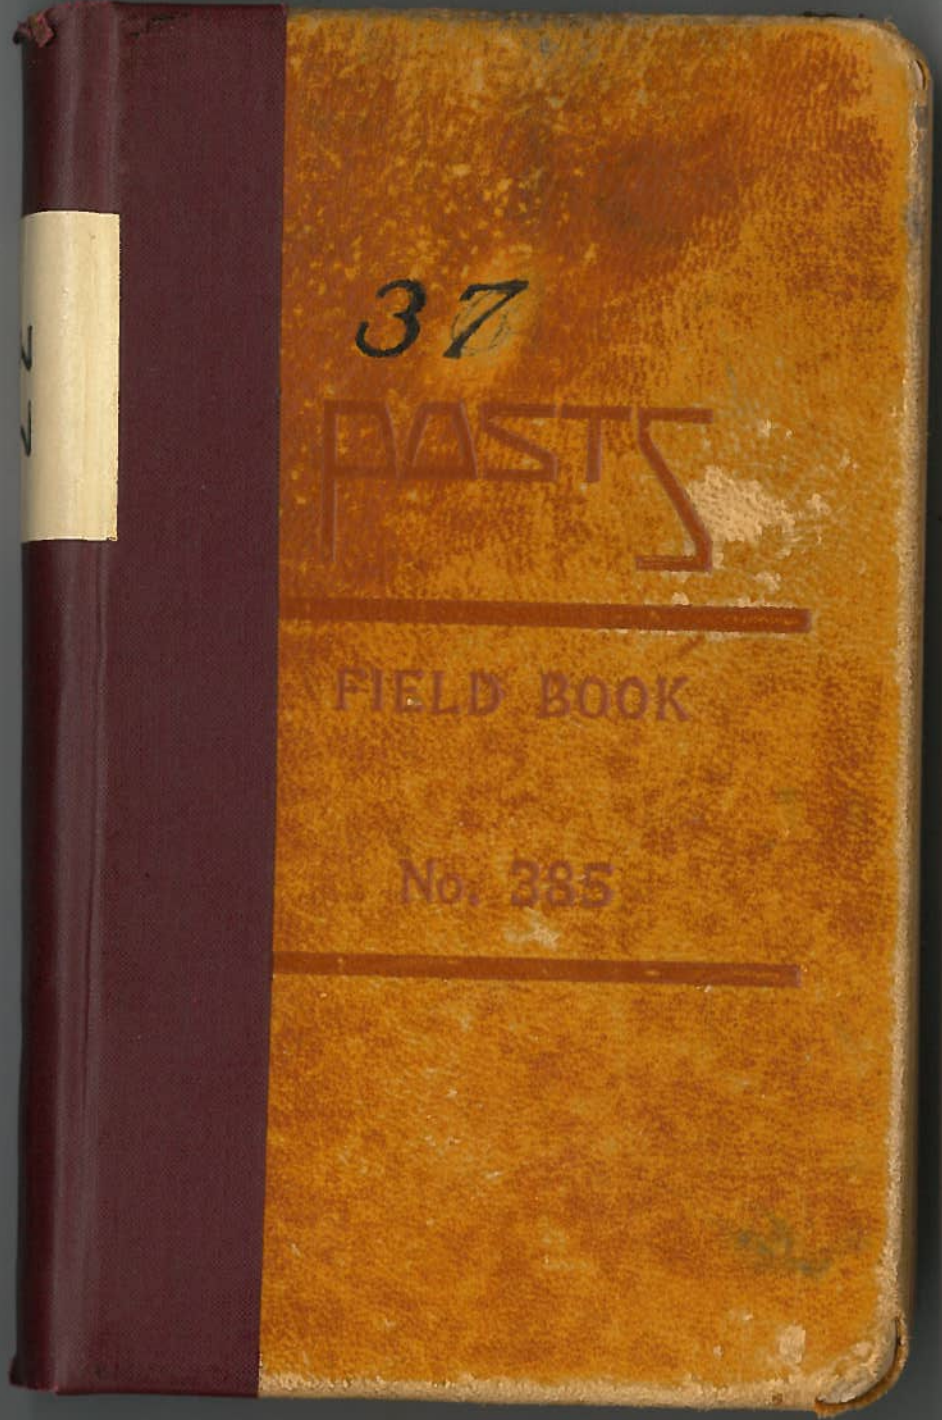
37
PASTS
FIELD BOOK
No. 385

1011
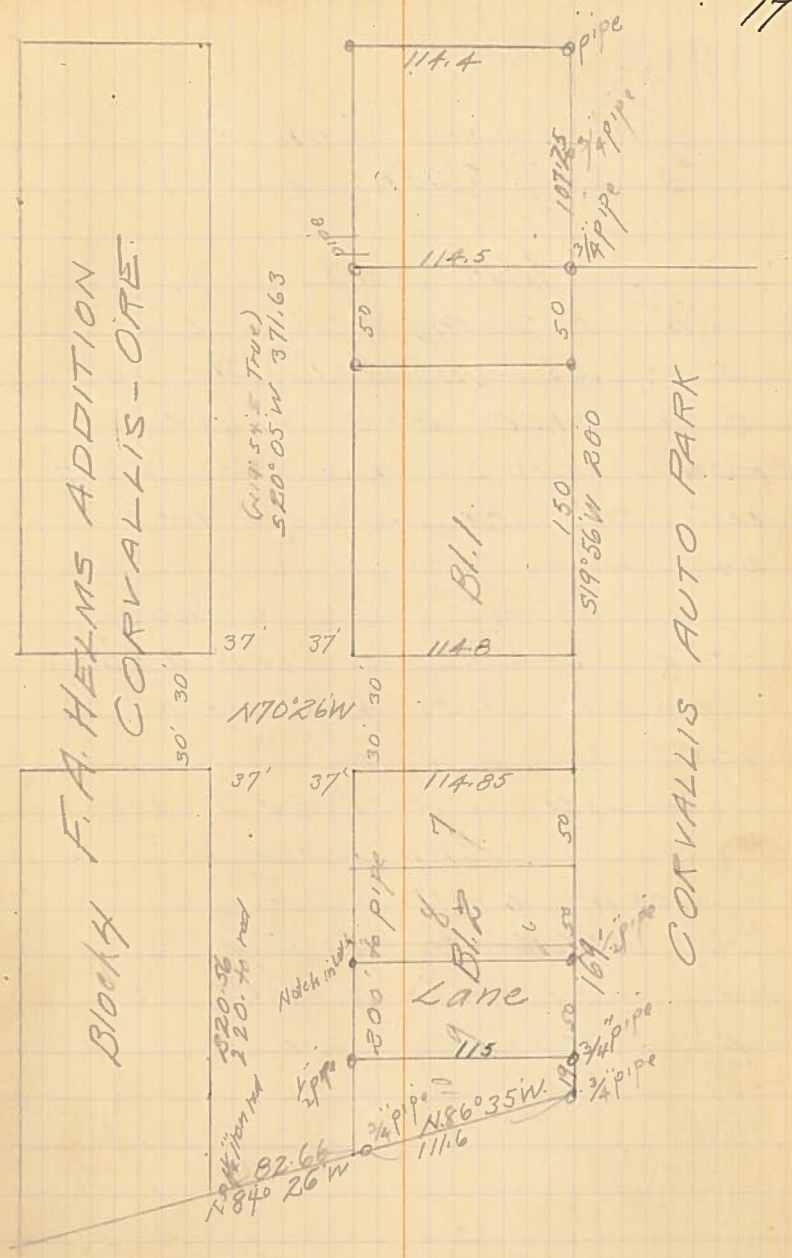
Survey for
Ralph Lane
Lot 9, Bl. 2
Helms Addition
Found ¾" pipe at N.E cor.
of Block. backsighted on
pipe about ±50' N. and
run south 100' set pipe
at 150' set pipe. From
beginning run W along S. side
of D. Street to sidewalk,
thence south along walk
100 ft. marked walk, at
150 set ½" pipe.
House sets over on
lot 8 about 2 feet.
about 9 ft. off of lot
8 would be needed to
make front the right size
for house + walk.