C.S. 1013

SEE NOTES IN FILE

FIELD BOOK 37, PAGE 19

37

PAST 5

FIELD BOOK

No. 385

1013
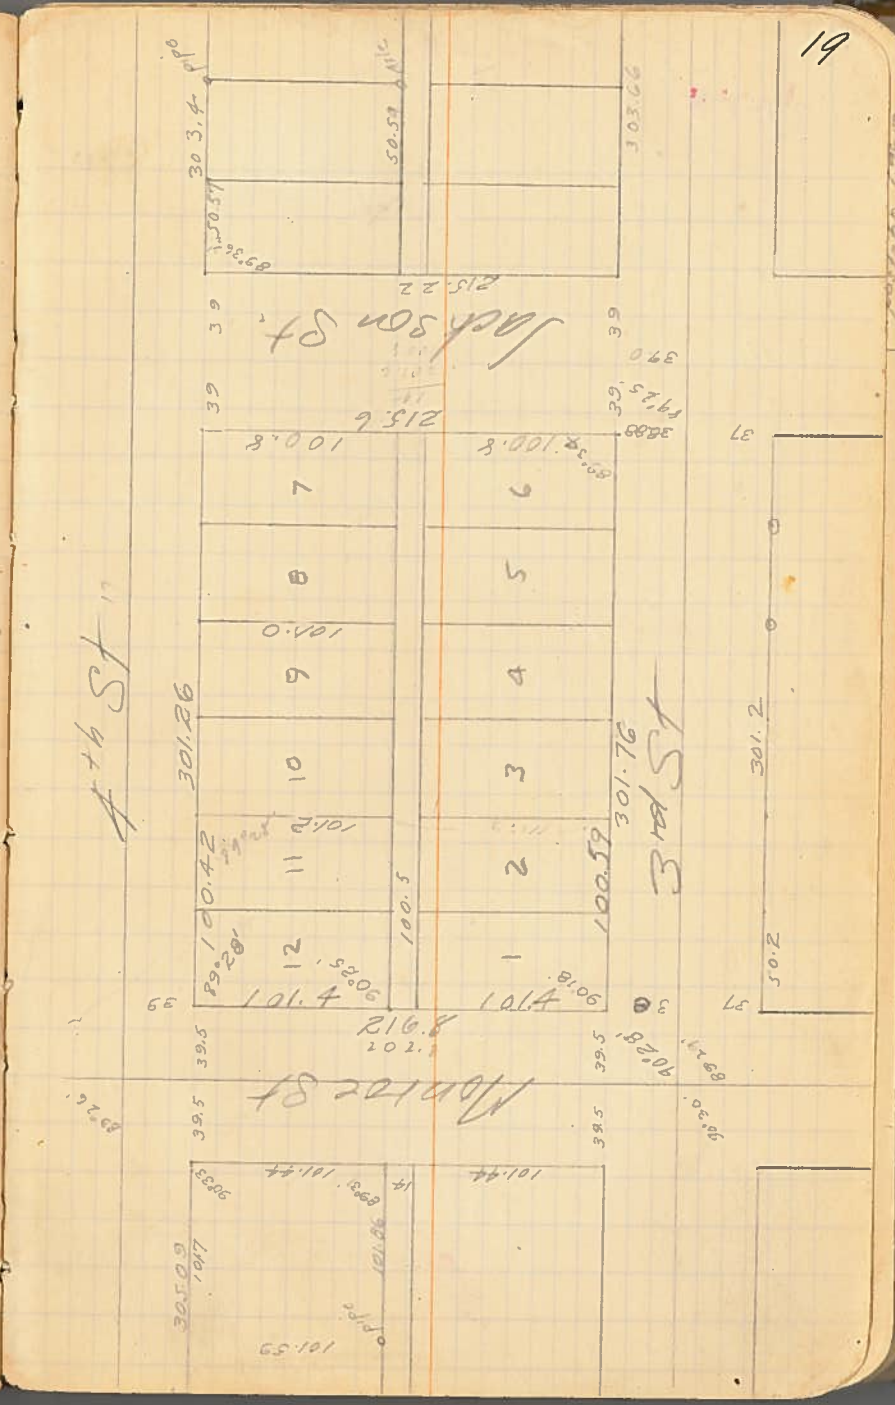
Survey for Elmore Hotel Property - Mr. Oxford owner.