C.S. # 1015

Hardcopy 11-5 # 25

also see notes in file

F. B. 36-26

X14.5

26 1015

C.S. 290 Continued

For Fred Hughes Jan. 12, 1927.
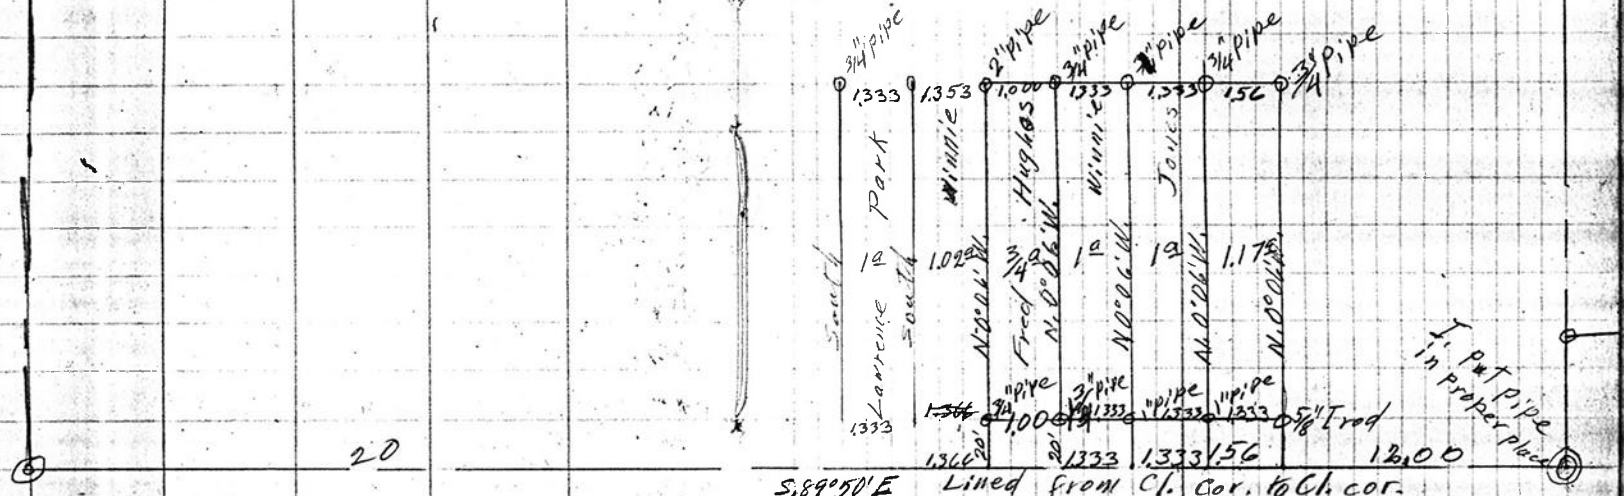
James L. Mulkey Sr. D.L.C. #63 T.11-5