C.S. # 1020

Hardcopy City Plat #8

also see notes in file

F. B. 37-22

X14.5

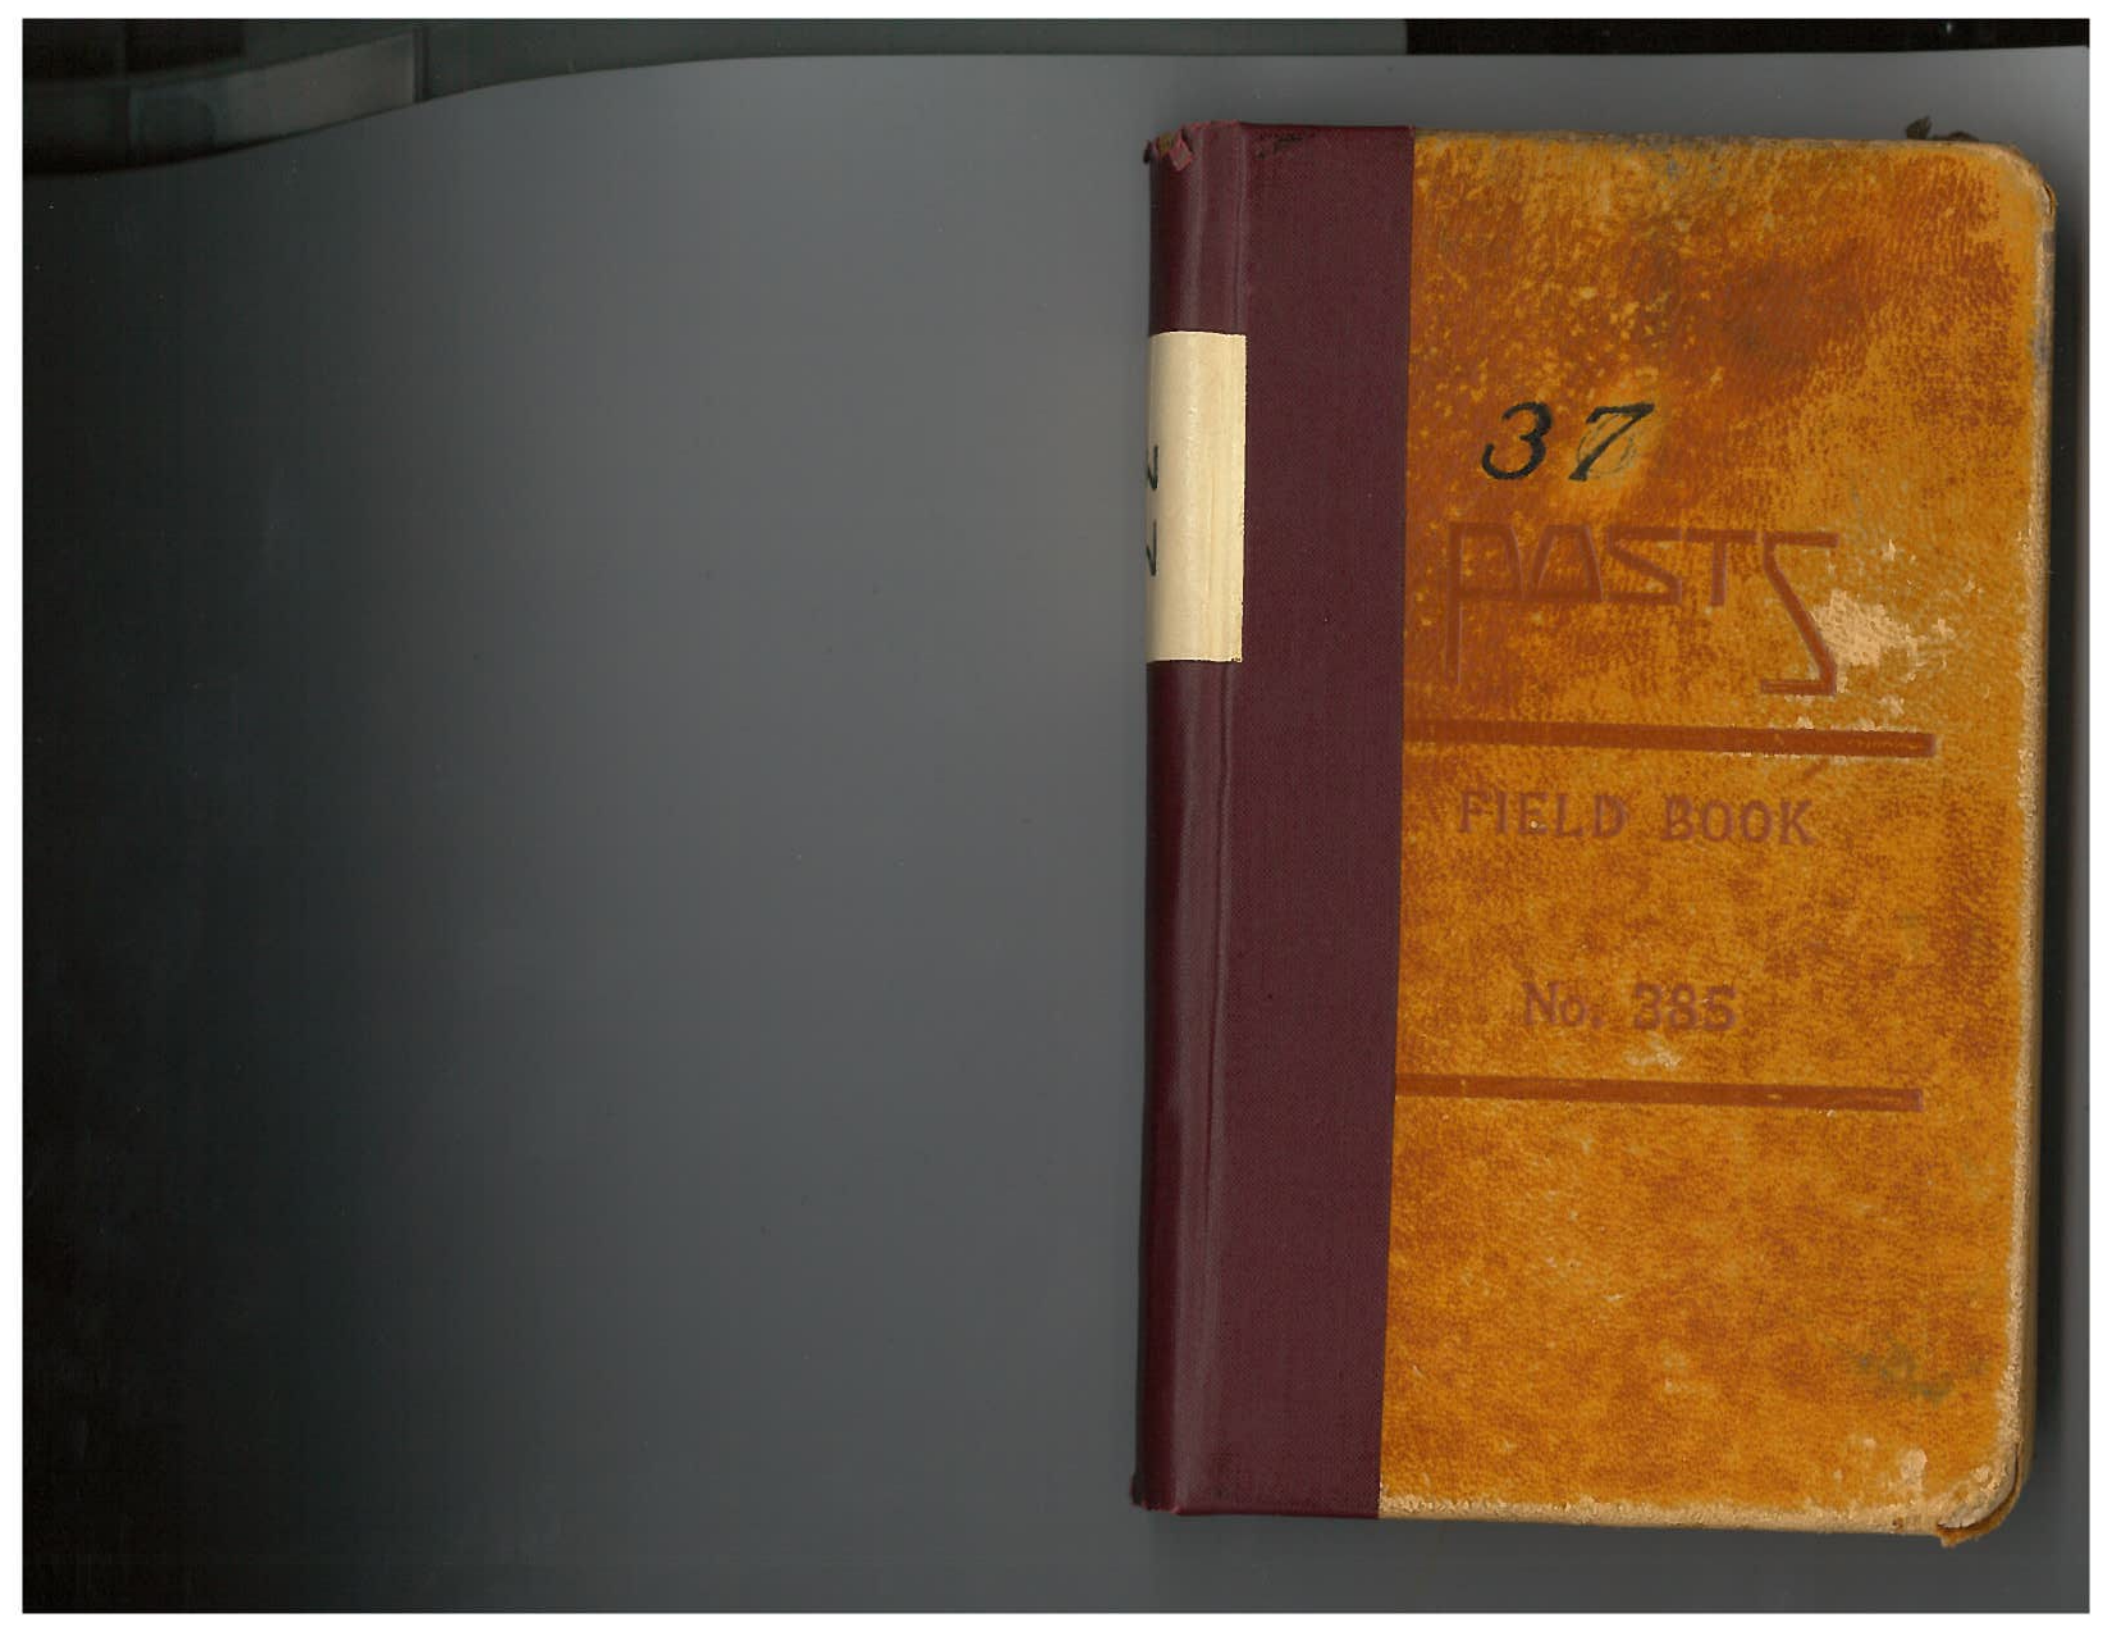
37
PASTS
FIELD BOOK
No. 385

1020 Miscellaneous

Survey for new site of Corvallis Hotel. 2nd & Madison
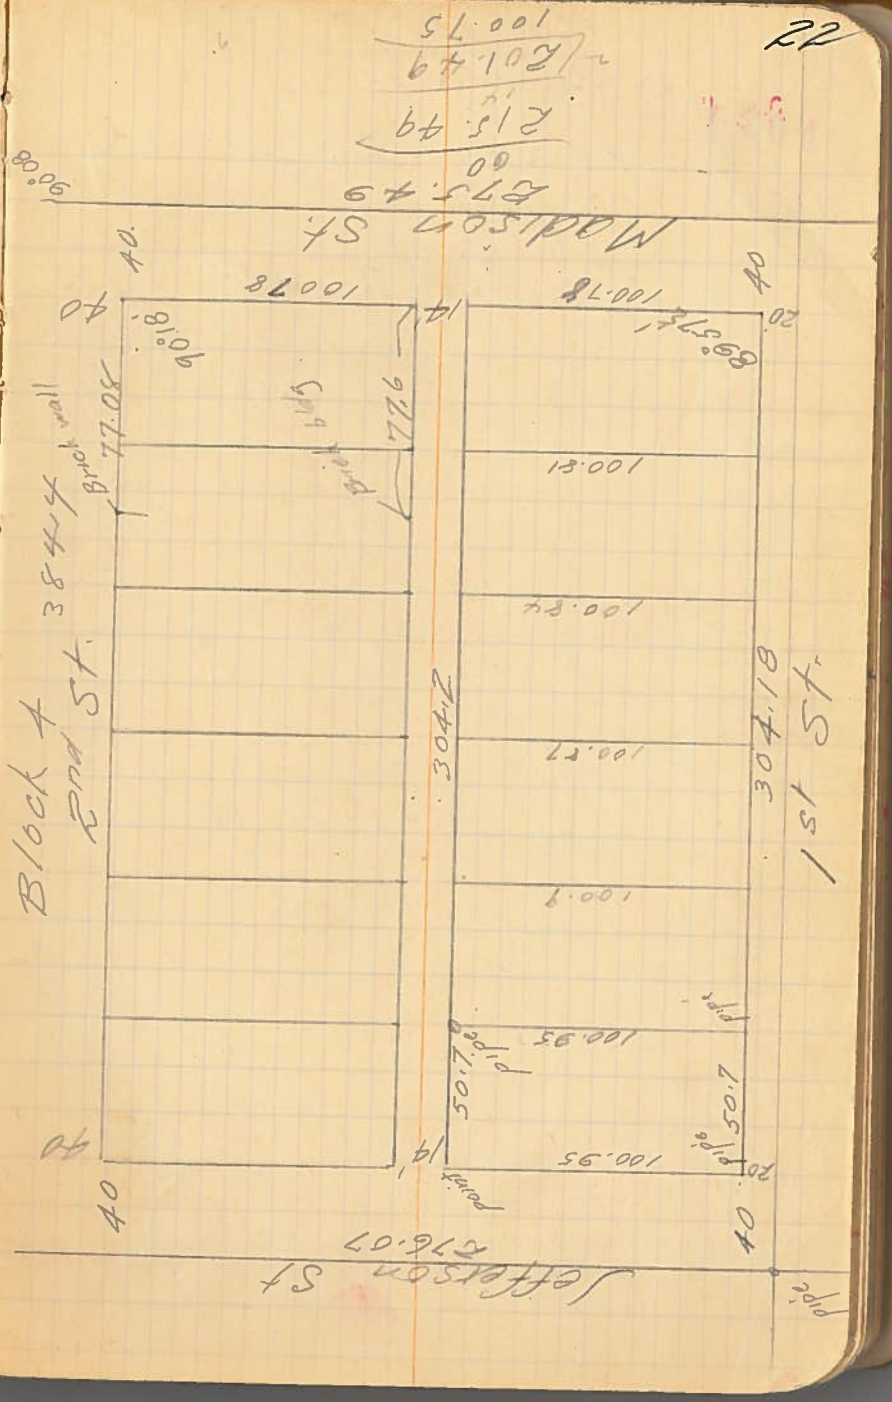
Top Walk N.W. Kline Blk	3.29
20' N	3.38
40' N	3.39
60' N	3.43
N.W. Cor Bl	3.38
20' E	3.56
40' E	3.63
60' E	3.66
80' E	3.75
N.E. Cor. 100' E	4.00
S.E. Cor	4.05