C.S. # 1021

Hardcopy 14-4 # 3

also see notes in file

F. B. 37-23

X14.5

1021

1021

County Survey No. 1021

FB #37

C. S. 222

1021

Began at ½" pipe at ☙
Ran South

5.000
Set 4"x4" Ash Stake 0.17 S. 1.78 N S 1° 46' E
5.034 Correct 2°02' E 50° 17' W
hit .355 E of ½ pipe
7.480 and .022 N
2.554
hit .709 E + .020 N of ½
19.215

Began at a ½ pipe 23.225
Tot. oz E of SW cor
S 89° 30' E
0°14' Correct 0°06' S.

9.135 1°0'R .037 N
3.414 0°0' .060
5.310 —.99 + .0065 is a ½ pipi Ash 12" S 40° W 4.75

9.930 .0955
9.158 Correct 0°24' S .1385
4.854 .1725
4.375
0°18' R .202 S
8.464 2°18' R .0445 .216 S
8.136 .1265
hit .113 Not on

Doernbecher

T. 14 S. R 4 W

23

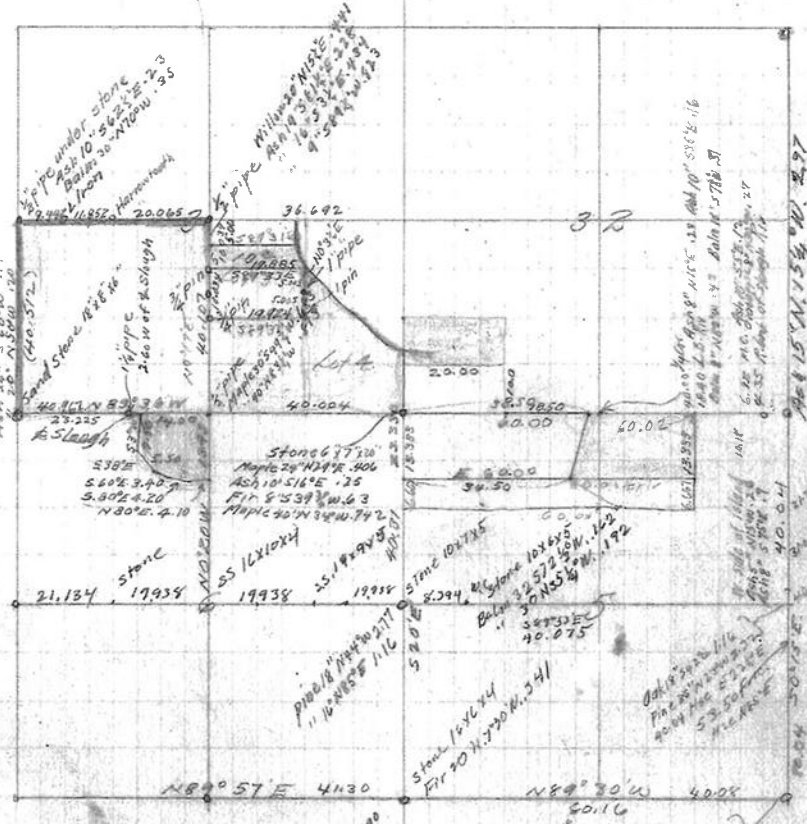

.006 N	.202 N
.069 N	.069 N
.075 N	.271 N
.063 N	.069 N
.138 N	.202 N
.034 N	.034 N
.172 N	.236 N
.030	.113
.202 N	

.2771
.0069 = 0° 24'