10-4
33 & 34

COUNTY SURVEY NO. 353

C.S. #1038

FOR N.H. HANSEN W.C. GALLOWAY C.S.

JACOB L. HALTER D.L.C. NO. 73

SECTIONS 28 & 33 T.10S., R4W., SCALE 1"=10 CHS.

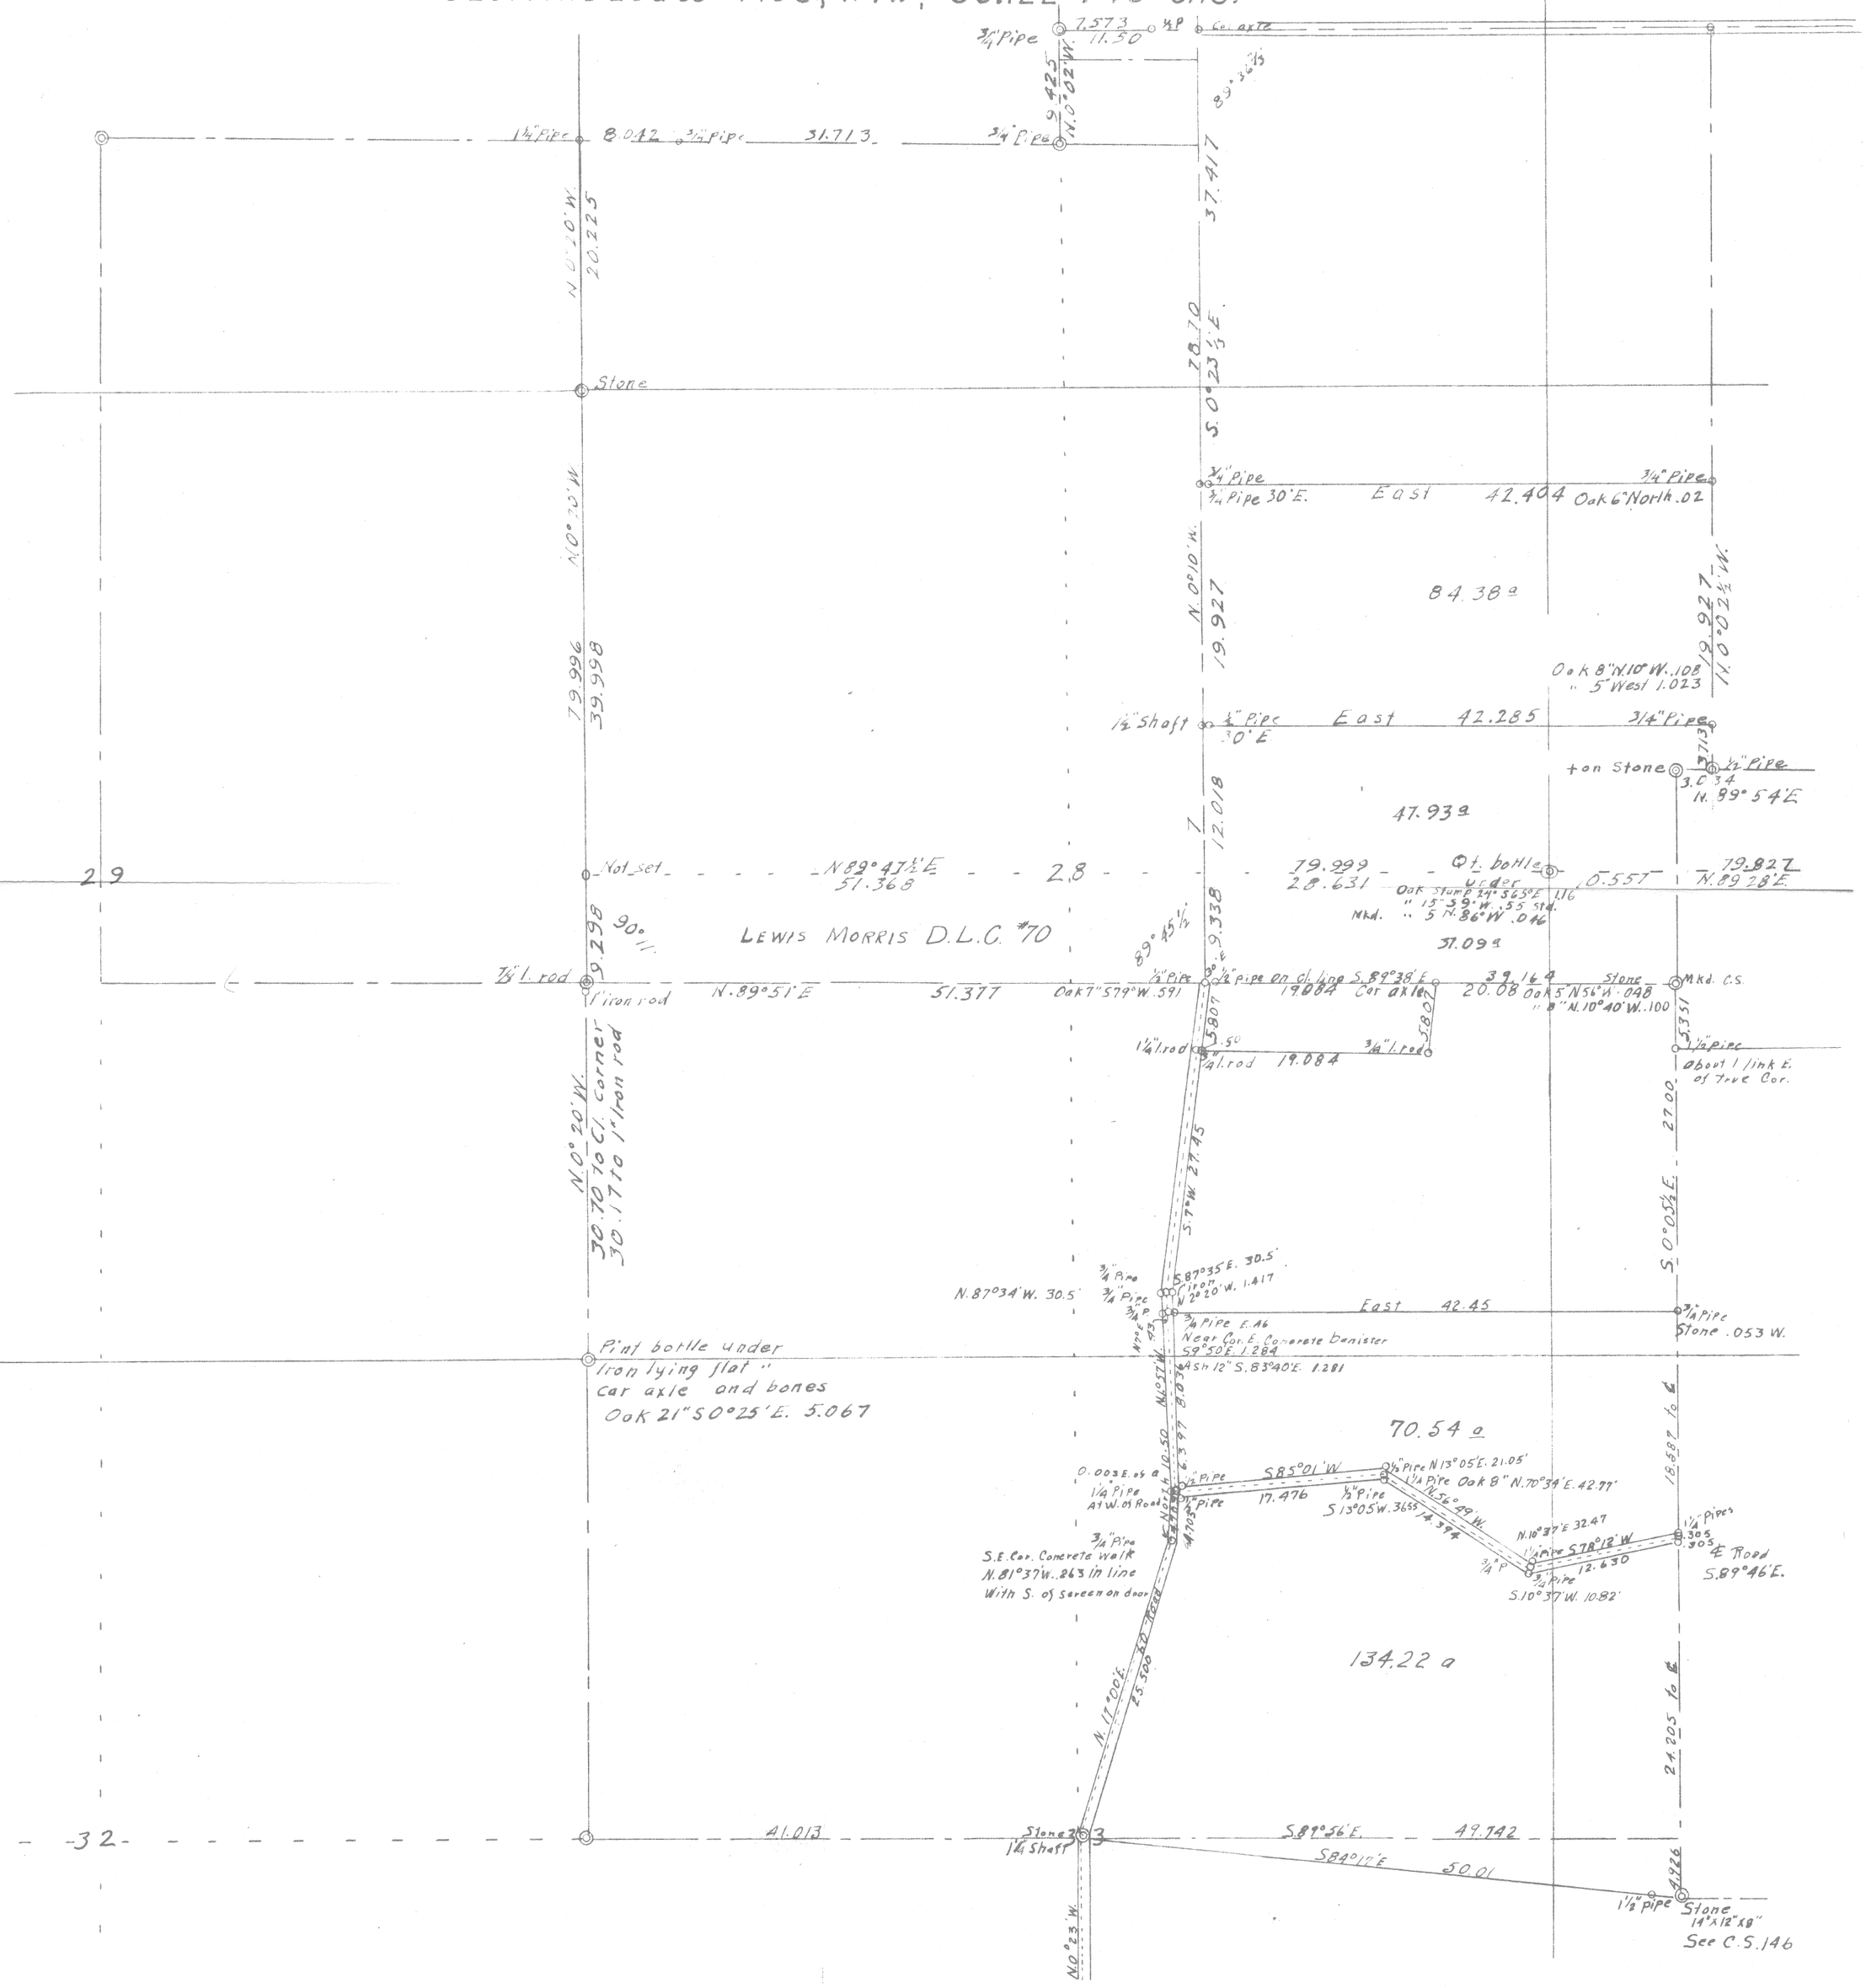

F/B 36 Pg. 55 C.S.# 1038

55

1038

C.S. 353 T 10-4

Beginning at the N.E. cor. of Anthony Roberts Cl. 55 Backsighted S.0°26'E.

	N.17° E.		17.202	.202 .023 .179
1	correct W. 04'		8.298	
2	Set ½" Sq. Pipe		W. .030	
	S.E. cor. of Concrete Walk		N81°37' W. .268	in line with S. of screen on front door
3	North		1.336	of 2.773
		-1°45'	8.000	Striking E.
	Set ¾" Pipe	.010 E. of W. fence and .197 S. of	1.168	North .009
4		(N 1°24' W 8.466) Jocor. ¾" Pipe (N 1°32' E 8.466)	W. .031	To L in 1004
5	N. 1° 50' W.		9.897	
	S. 2° 37' E.		1.231	which is S. 7°41' W. 2.773
6	Set ¾" pipe	S. 2°37' E. .203	& W. .008	
	" ¾" Pipe East .460			
	Near cor. of E. concrete Banister		S. 9°50' E 1.284	
	℄ in Road N. 2°20' W. 1.417			
	A.z. 12° S. 83°40' E. 1.281			Which is first Tree
	N. 89° 47' E		8.000	
	correction S. 10'	+ 6°	2.305	S. .238
7		+13°43'	4.000	S. .235
8		-2°25'	8.000	S. .268
9		+8°5'	8.000	
		+3°40'	8.000	
		+5°35'	4.190	Measured N
10			.117	Measured N 10°16' W
11	Set	for cor. S0°10'E. .326		Set nail .03 E. of Stake
	S 0° 10' E.	-5°10'	8.000	
		-1°35	8.000	
			2.648	To
13	C. Road S 78°12' W.		+ .305 &	N. of Road

(Corset 3'W. or N.23°W.)

Back sighted S.0°26'E. To R.R. ℄ 4°24' or R.R. bng. N.6°32'E.

For Sept. 30, 1927

Nicholas H. Hansen

I.C. Merchant Chairman

oak 3" N.96° W. .042 2 Stones

" 8 N.10°40' W. .100 5.358 1" Pipe

27.00 To 23.5

25.50 17.202 8.298

10.500 8.332 1.168

9.897

S. 2°37' E. ℄ road

cor. S.E. alder Morris Cl.

.97148 4 388592

+12°15' 8.000 7.992 3.275 27.257

+12°30' 8.000

3.275

27.00 .326

N. 49°4 4.964 7.981 7.995

-4° 8.000 -1° 8.000

Tot in total .358 Pipe .358 20.940 3.317 2.417 26.674

+4°55' 3.330 21.329 5.351 26.674

-1°30' 2.418 326 27.000 to set .326 S. .160 .166

N 73 E Tree 6 Ft to Cl. cor.

Set W. of W. end

3.292 3.584 7.992 7.999 7.984 4.182 .117 42.457 .001 42.456

7.968 7.992 2.648 .305 18.913