C.S. # 1042

Hardcopy 11-4 #15

also see notes in file

F. B. 37-32

FB 37

1042

C. S. 182 Con. For Harry Asb and T.

		Azimuth	Azimuth
-6°40'	3.519		
3.543			-19°30'
△		65°54'R	+.717 = .676 pipe ℄ Cr
4.692			
△		54°31'R	50°L 92 ℄ Cr
3.439			5°R 330 "
△		97°52'R	12°30' L 1.66 ℄ Cr
3.547			
△		94°27'R	10°R 1.40 ℄ Cr
4.674			
△ pipe			0° 1.084 Cr.

20,21 - T. 11 - 4.

43.081
27.225
15.856

N 19° 12' E
69.46

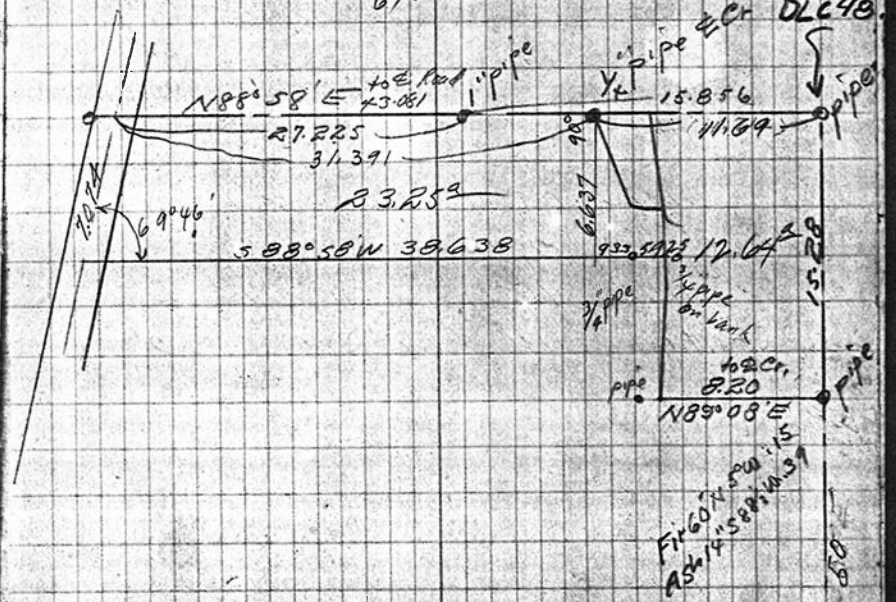

Nub to cor
12.361