C.S. # 1048

Orchard View Tracts

F.B. 37-45

FB 37

1048

C.S. 160

Survey for Jack Richards

Note by CRB
Being parts of Lots 10, 11, 12, 13 & 14 Blk 1
Orchard View Tracts
Dashed Data by CRB 2-25-1954

T. 14S R 5W
Sec 33
Nov 19, 1927
Orchard View tracts
Lot 9, Bl. 1

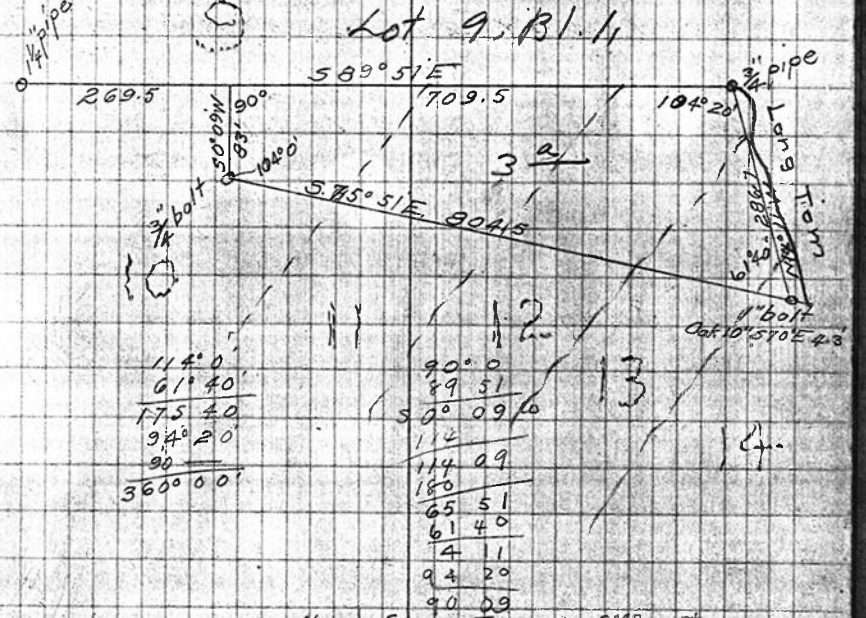

114° 0'
61° 40'
175° 40'
90
360° 00'

90° 0
89 51
30° 09
1 12
114 09
180
65 51
61 40
4 11
94 20
90 09

	N	S	E	W	DMD	E	S
S 89° 51 E 709.5		1.9	709.5		709.5		1,350.0
S 14° 11' E 286.7		278.0	70.9		1489.9		414.000
N 75° 51' W 804.5	196.6			780.1	779.7	153000	
N 0° 09' E 83.0	83.0		0.2		0.2	16.6	
	279.6	279.9	780.11	780.11		153016	1764.0

415.350
52016
25.2334
134.167