C.S. # 1051

Dixon's Addition
Block 5

F.B. 84-29

FB 84

29

1051

Lots 7 + 8 Bk. 5 - Ok. Add'l.
Survey for Mrs Bingman
Dec 28, 1927
Began at the monument on ℄ of 3rd Harrison - checked in to sidewalk - measured to walk south - OK. from ℄ - measured east - checked walks - measured north to walk - checked in from ℄ - measured west to beginning - Proportioned for lots and set pipes according to deeds.

30

3 (304.33
101.44
45.75
55.69
215.62
14
2 (201.62
100.81

214.7
14
2 (200.7
100.35

3 (302.55
100.85
101.44
(202.29
101.14
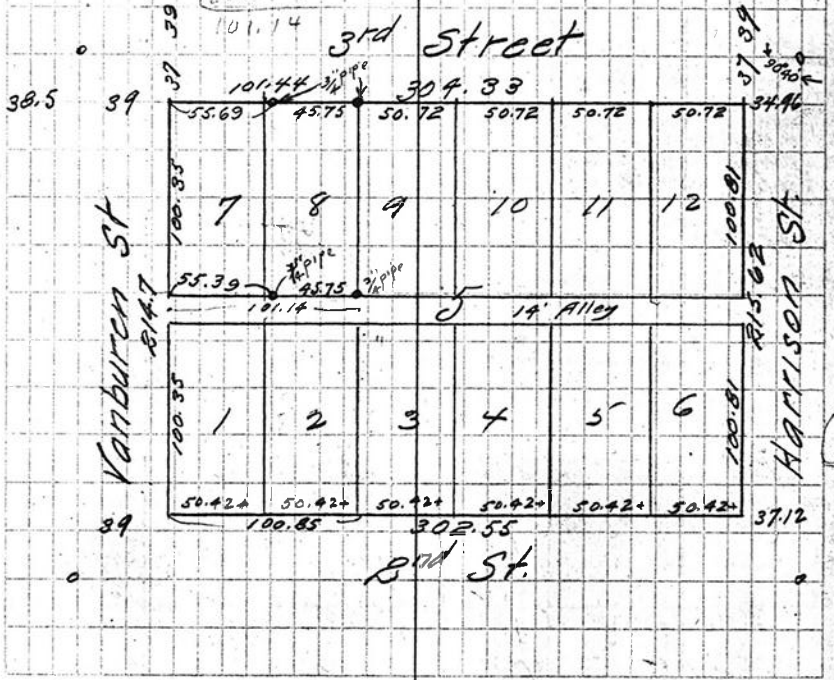
N 304.33
90°40'
N 215.62
E 302.55
S 214.7