C.S. # 1054

See notes in file

F.B. 37-53

FB#37

1054 C.S. 160

10.475
4.683
15.108

5.000 5.000
5.483 5.475 10.475

Beginning at a point 4.633 chs N89°54'W and 23.283 chs ~~North~~ N0°01'E of the center ~~of the~~ of section 33, T. 14S. R. 5W. of the Will Mer. in Benton County, Oregon; and running thence S. 0°01'W 14.608 chains to a 1¼" pipe, thence N89°53'W 10.228 chains to a 1¼" pipe, thence N0°18'W 14.608 chains, thence S89°53'E 10.309 chains to the place of beginning containing 15.0 acres.

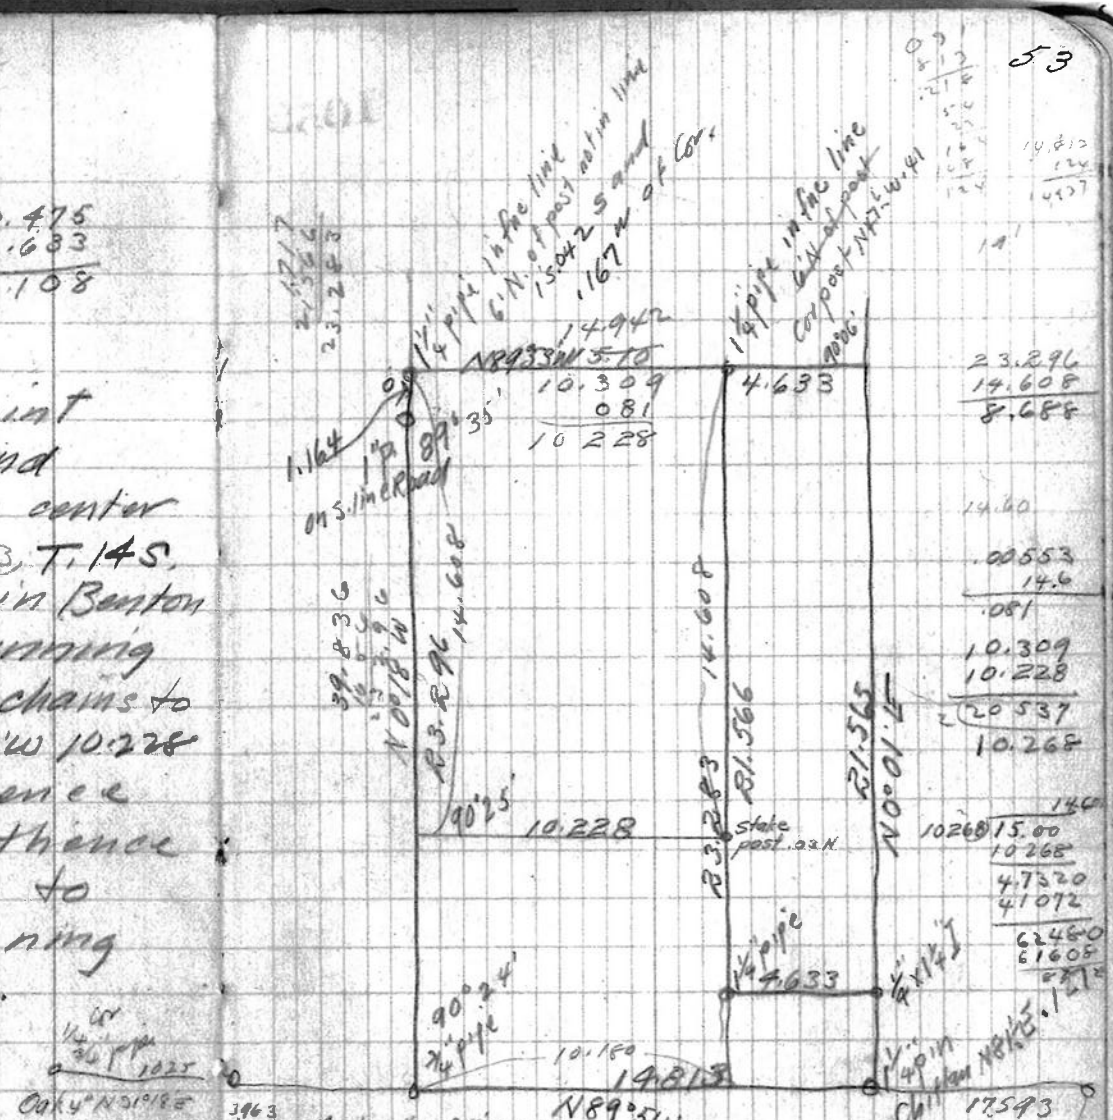

53

23.296
14.608
8.688

14.60
.00553
14.6
.081
10.309
10.228
20 537
10.268

140
10268 15.00
10268
4.7320
41072
62460
61605
855

14.813
4.633
10.180