C.S. # 1057

Hardcopy 13-5 #17

also see notes in file

F. B. 37-60

37

EASTY

FIELD BOOK

No. 385

C.S. 245

Feb 28 1928

1057 T. 13 S R 5 W

Began at a point
31.14 chs W. of N.E. Cor
Grimsley Cl. 49
Set 3/4" pipe in south
track of road. Sight on
Corner East
90°0'R

30.00
.600
14.373
5.000
15.000
5.000
15.000
20.597
75.470

3/4" pipe & stake
offset 1.00 S.

hit .997 S. of Cor

90° 19' L to Cl. line S.

13.372
+.025
13.397 to ℄ on Ellinjaw.
122 Stob Sign
15.519 to ℄ Pav.

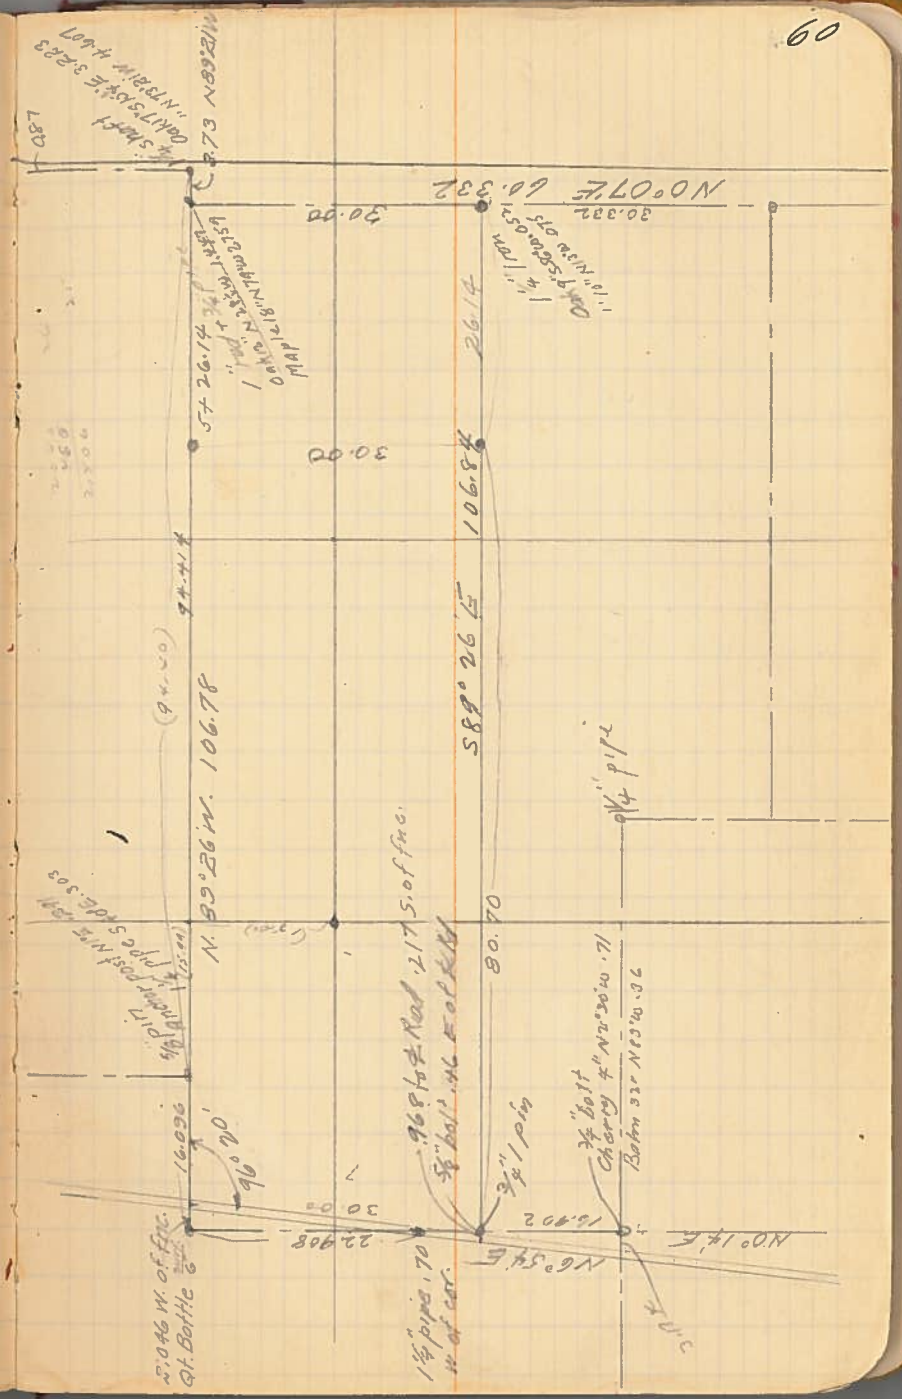
60
N 89°26' W. 106.78
S 89°26' E 106.78
N 0°07' E 60.332
30.332
30.00
26.14
80.70
20.00
Oak 4"x4" N 0.1' W
Oak 4"x4" N 13° W 0.1'
Stone
Oak 17"x5"x5" E 3.23
