C.S. # 1060

Hardcopy 12-5 # 12

also see notes in file

F. B. 37-69

FB 37

1060 C.S. 206

Wacomah Dairy

Cl. 47 – 125

Sec 11, 14, 15 T125R5W

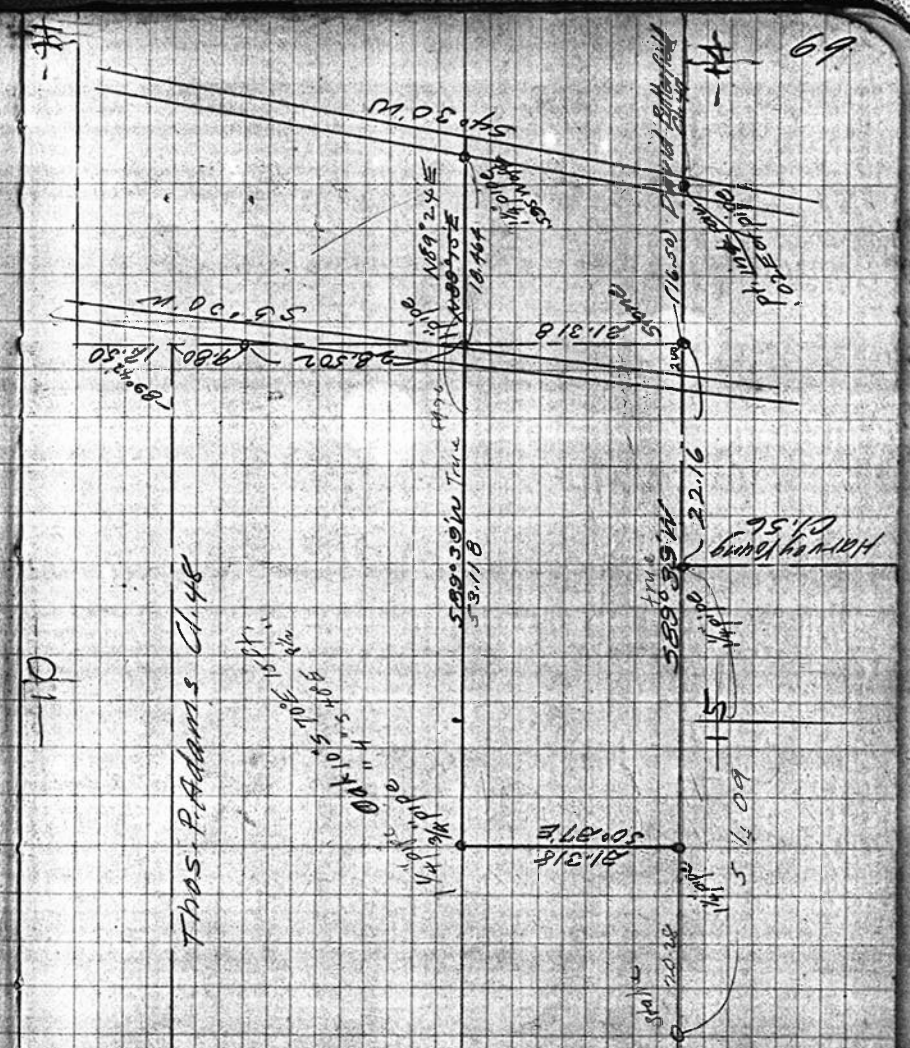
69
Thos. P. Adams Clm.
Harvey Young Clm.
S 89° 39' W True
