C.S. # 1068

College Homes
Block 2

F.B. 84-35

F/B 72, Pg 4-5

4

1068

Loc Gray

10.000

6318

4.970 4.948

0°17'R

2.370 2.370

4.588

0°0'.035

4.915 4.558

38.234

1.806 4.770

1°06'L

1.401 1.401

0°30'L .027N

3.001 3.929

hit pin 8N of Ø .1' p.

0°0' .026N

2.660 2.573

2.740 2.348

38485

1.610 4.529

.014

40

Set oak stake .0306

and .014W

Fir 40" N45°E .21

1360 | 100 | 10 | 10

1500 9520

864 480

404

720

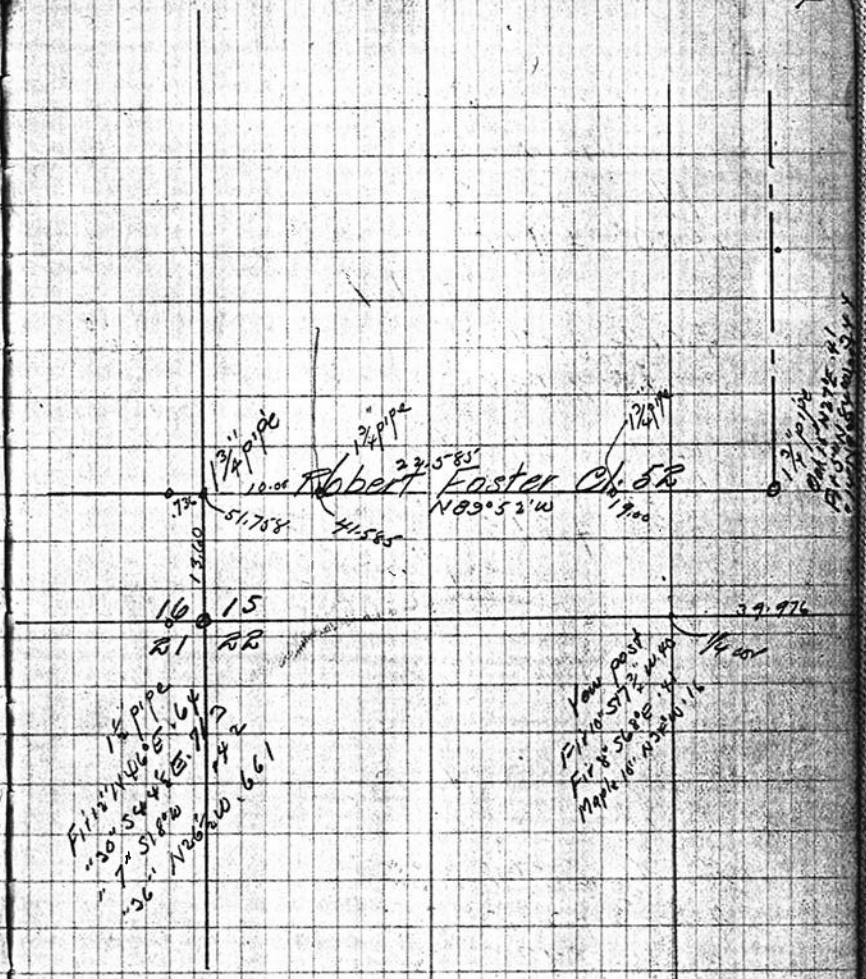

Began at point

S87½°E

1°49'L

S89°E

2°10'L

2°10'L

1°35'L

2°30'L

6°30'L

1°05'L

1°05'L

19.99

+0.02

2.687 2.680

.796 .768

4.900 4.900

4.012 3.992

2.645 2.628

1.065 1.029

4.950 4.885

18.20'

20.00

1.800 1.798

2

2.280 2.277

4.543 4.530

3.012 2.993

2.676 2.659

1.099 1.094

3.768 3.768

+7.31

040 N of ⊙ at .019S

at .116N

at 100N

at 089N .083

at 078N .039

at 030N .184

at .011N .008

at .011N .012N .013N

at .031S .118

at .235S .229

at .090S .077

.051N

.040N
126
083
039
184
068
062
125
082
118
122
071
051
1.171N
061S
1.110
.0277 = 1°35'N

corrected ⊙

.087N
118N
205N
074S
131N
123N
23 3N
07 05
23 3N
071N
294S
104S
09 0N
05 1N
04 52
071S
106

.040N
021S
.061
135 .019N
.135S
.116S
.110S
.226S
.126N
.100S
.072S
172S
053N
.089S
028S
.117S
039N
.078S
136S
.214S
184N
.0908
049S
.079S
021N
668N
.089N
062N
151N
089N
125N
126S
.058N
.031N
.027S
.087N

at .061N of New Station

FB 84

35

Mac
277.53
122.17

1068

400
8.56
15
423.56
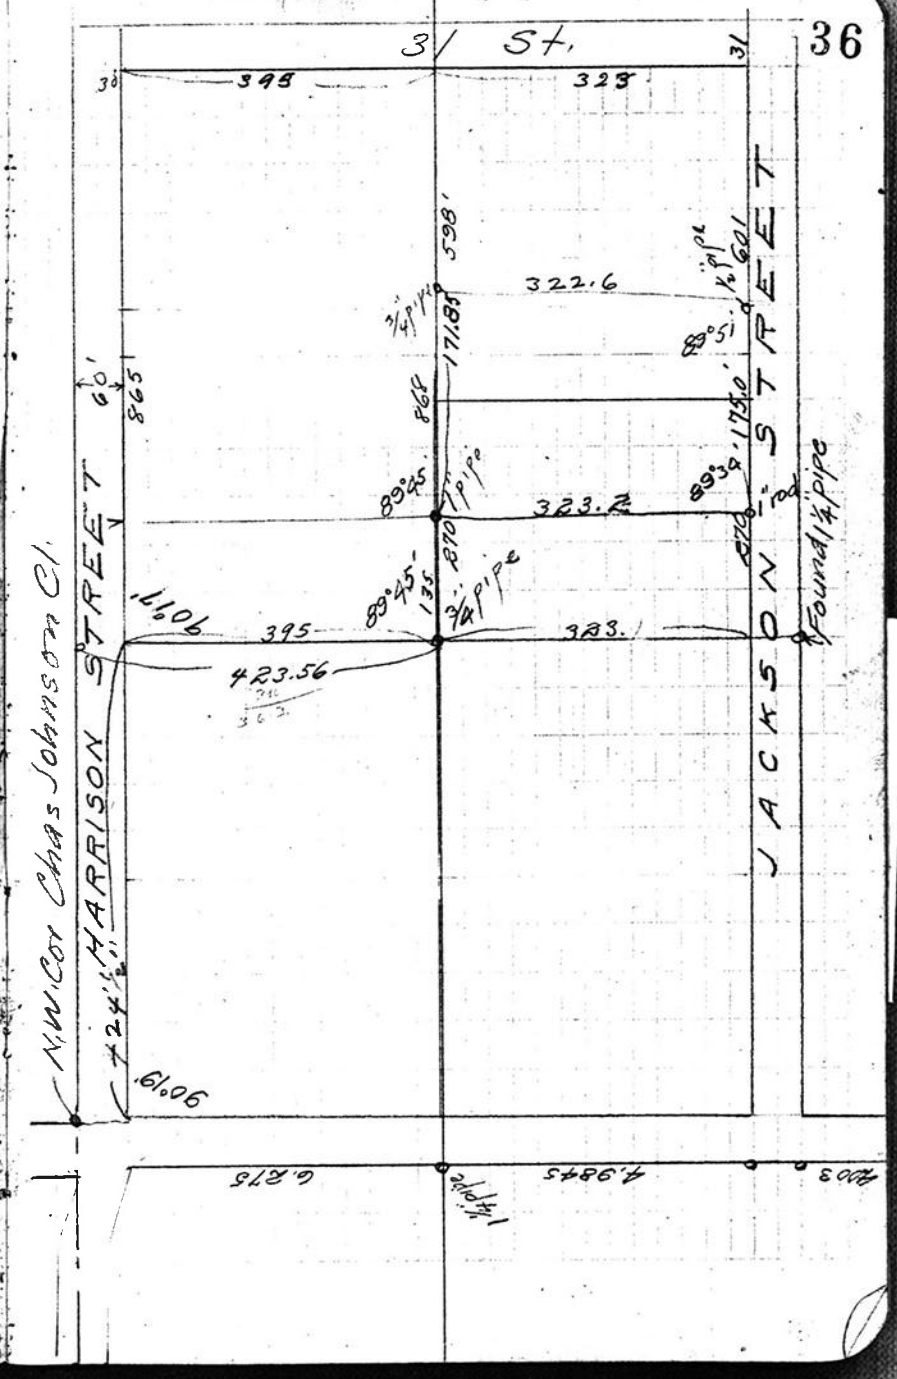
Survey for Barber on 33rd & Jackson. Began at the N.W. Corner of Chas. Johnson C152 Measured E 424.04' + 135' turn 90°17' R from walk line E