C.S. # 1074

Wells and McElroy Addition

Block 1

F.B. 84-45

FB#84

45

1074

Survey for Newton
May 2, 1928
W. W. L.

12.57
95) 12.0
95-5-
2450
1910
5400
4775
6250

42.40
6.28
36.12
1.56
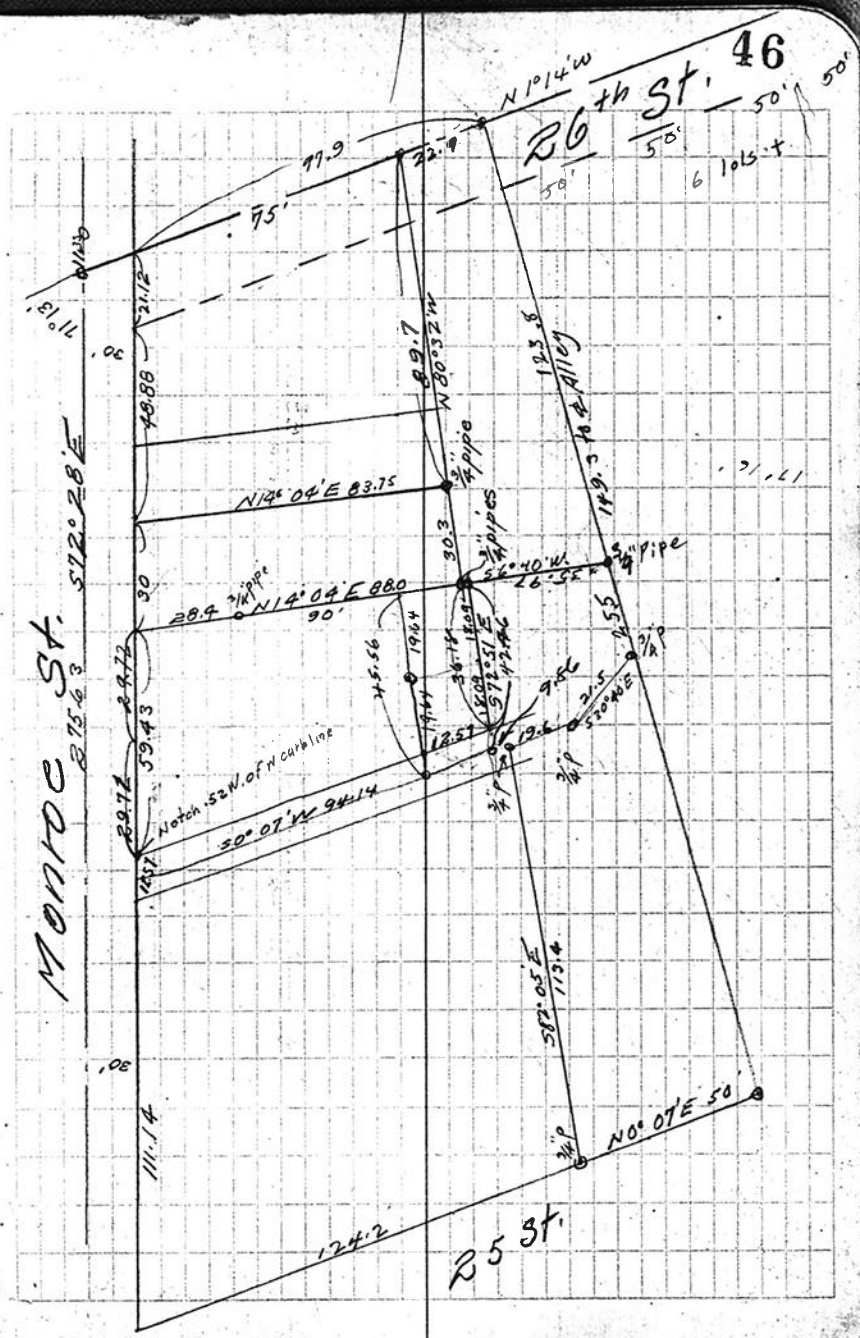
45.56
6.28
39.28
19.64
6.28
25.92