1075

1075

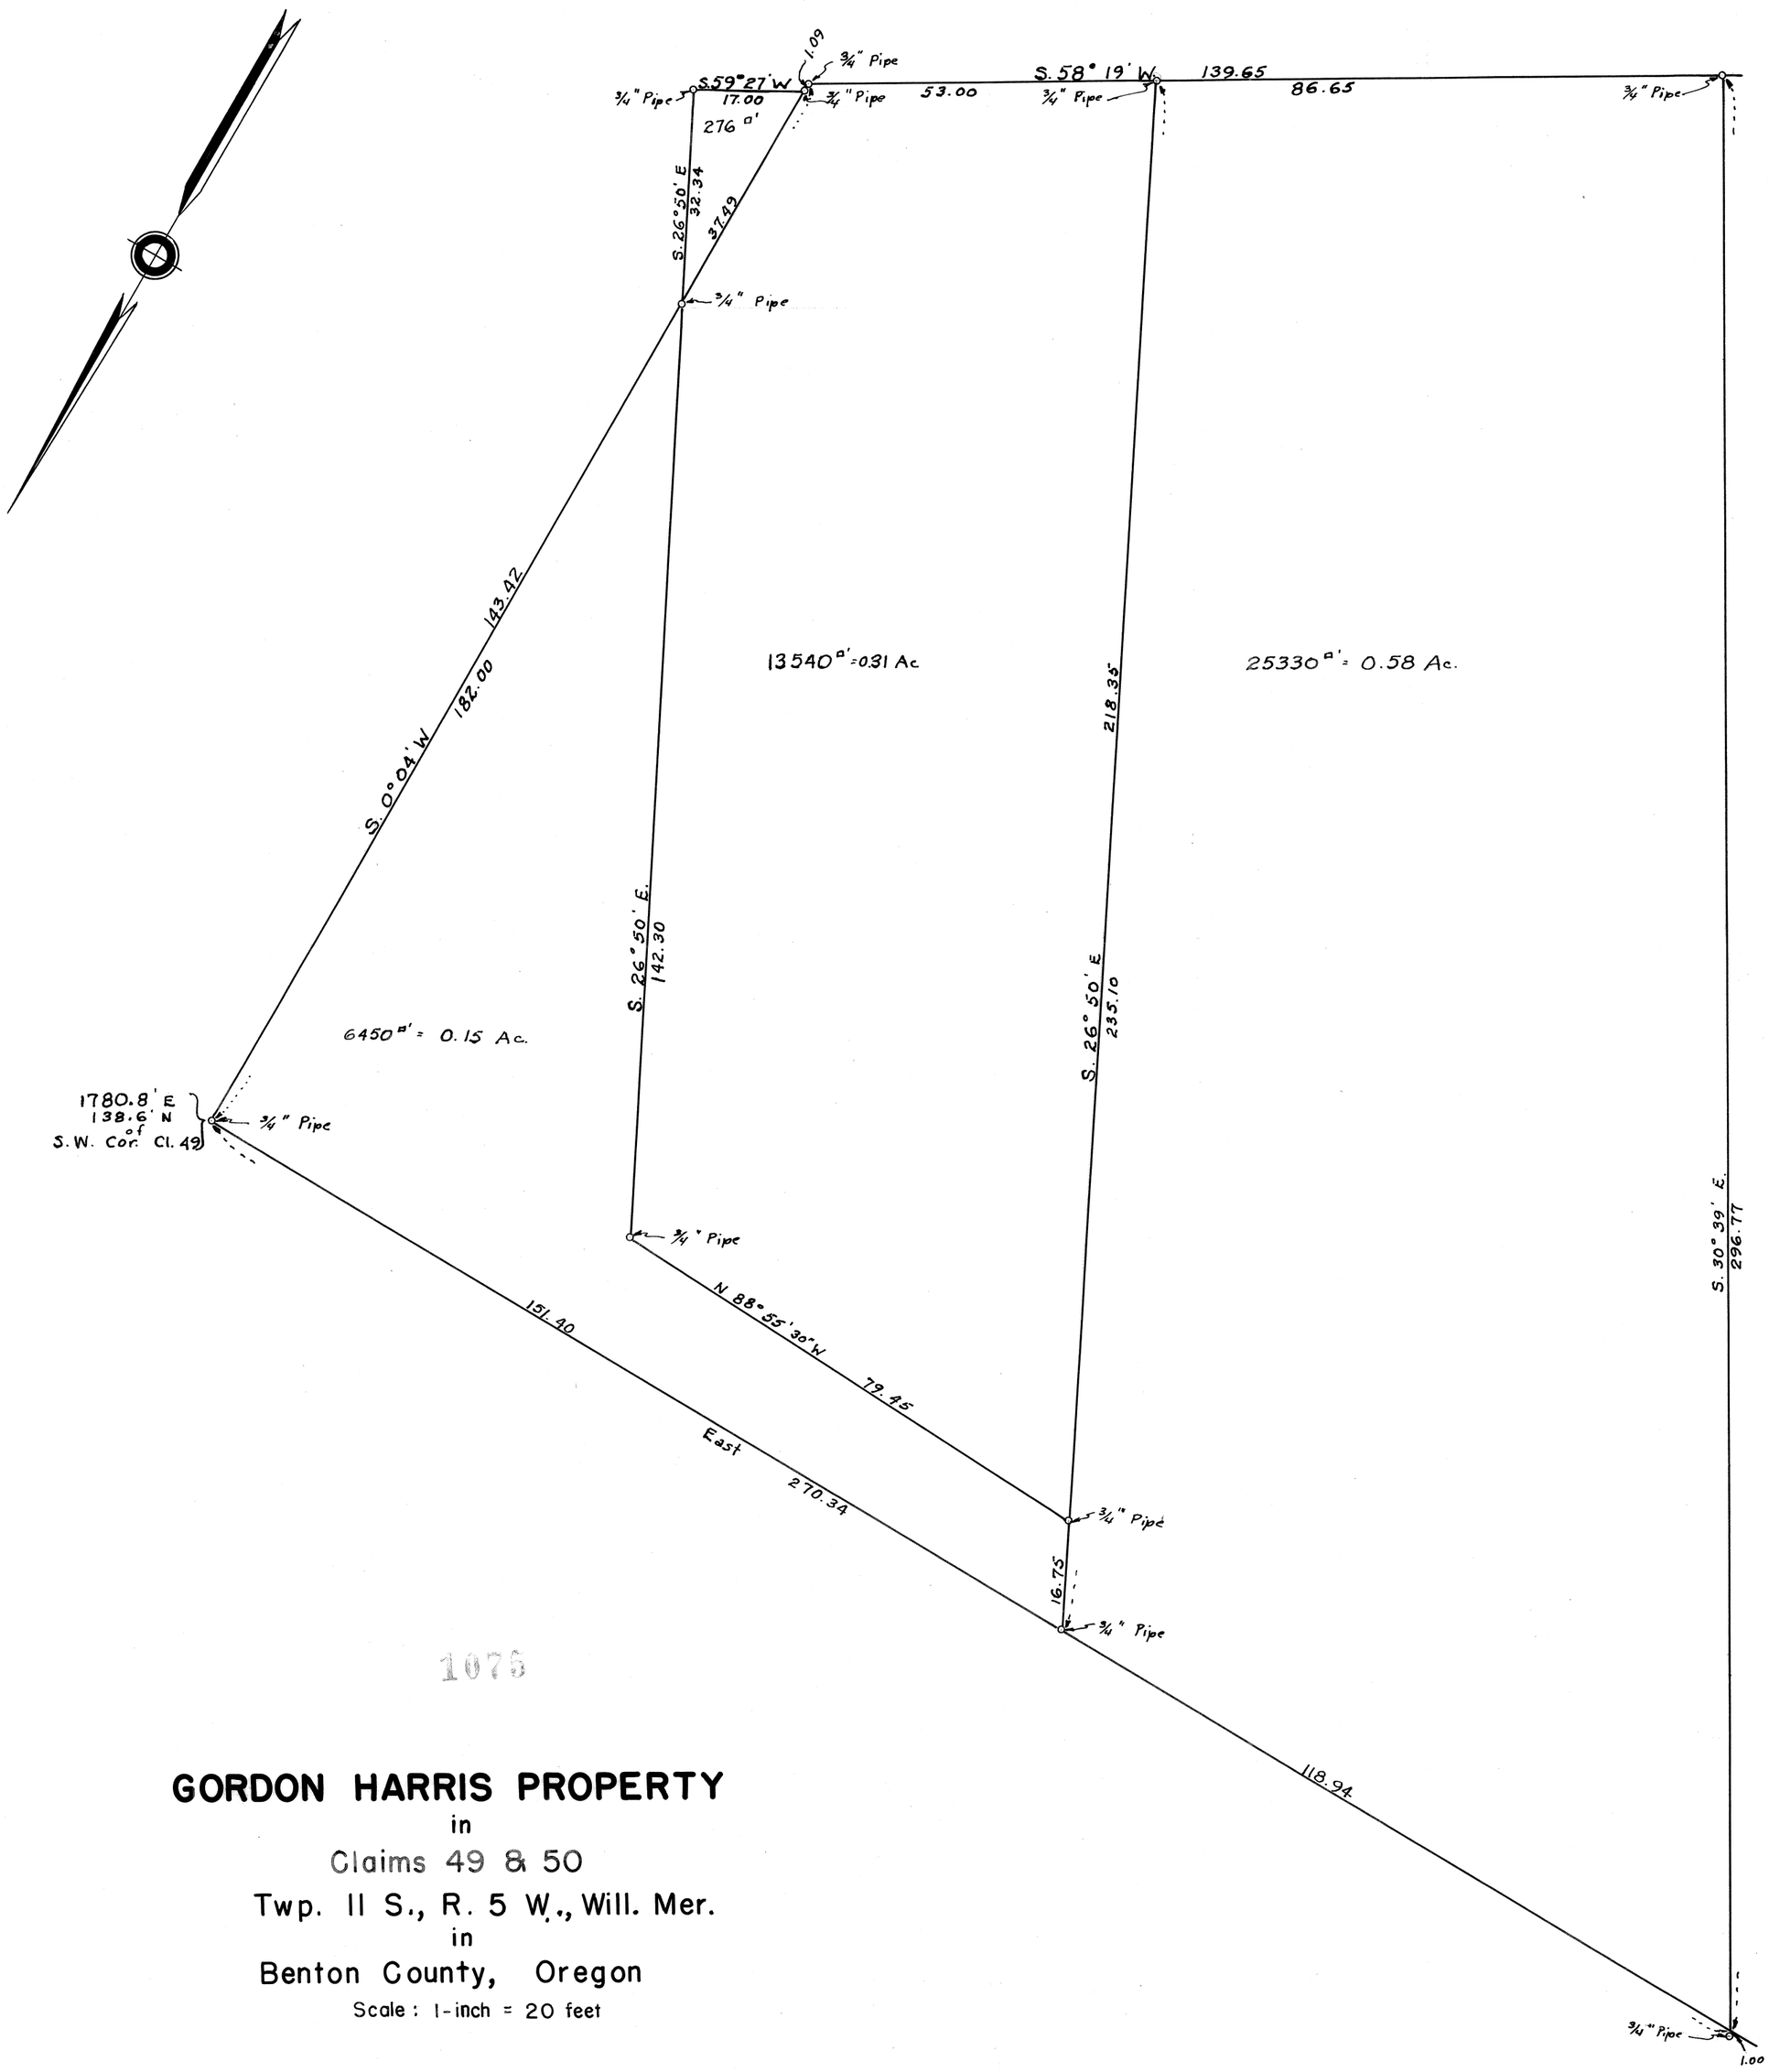


1075

# GORDON HARRIS PROPERTY

in

Claims 49 & 50

Twp. 11 S., R. 5 W., Will. Mer.

in

Benton County, Oregon

Scale : 1-inch = 20 feet