C.S. # 1077

County Addition

Block 1

F.B. 84-51

FB #84

51

1077

R16.8
14
R202.8
101.4

L 304.15
50.69

R16.7
14
R202.7
101.35

L 304.5
50.75

52
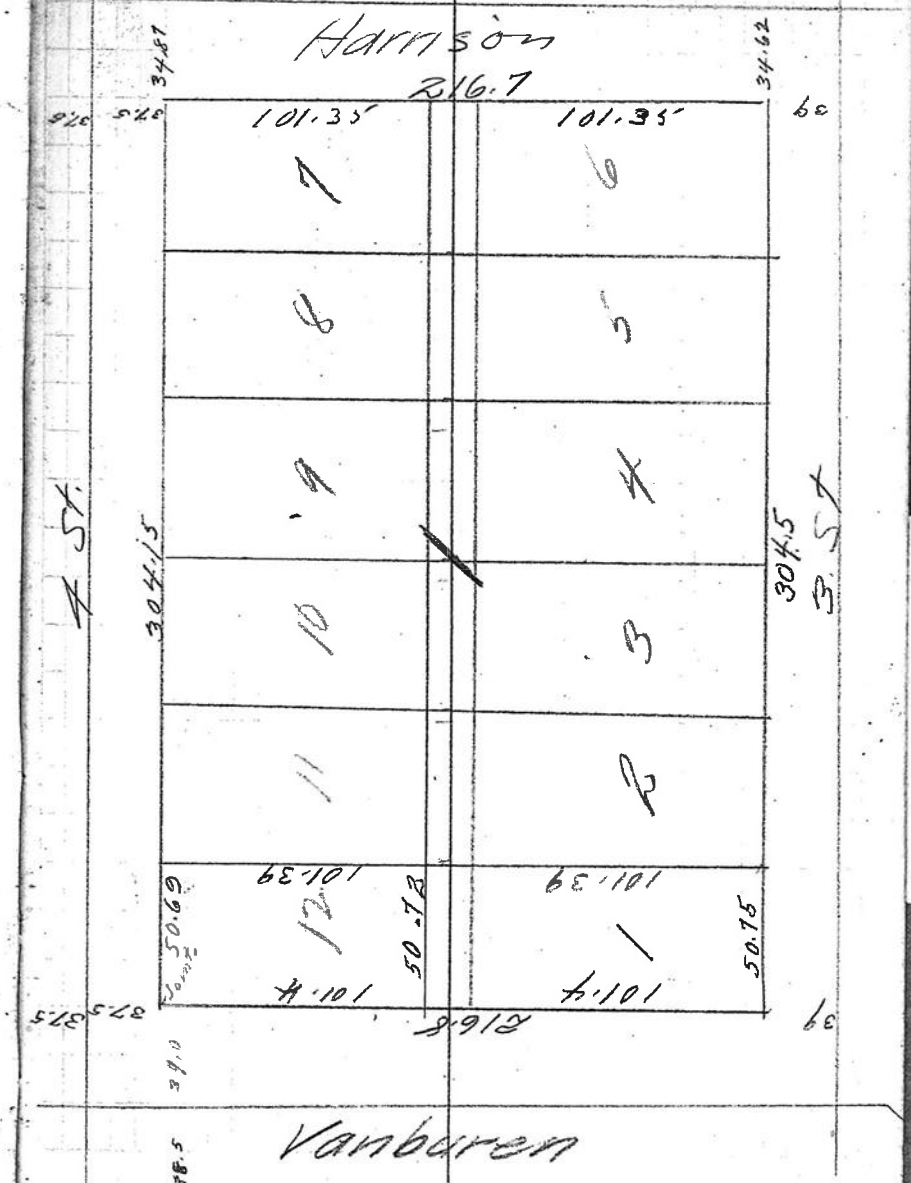
Block 1. - County Addition