C.S. # 1083

Supplement to College Hill
Block 8

F.B. 84-57

FB #84

57

1083

Supplemental of College Hill Add 58

For John Beach
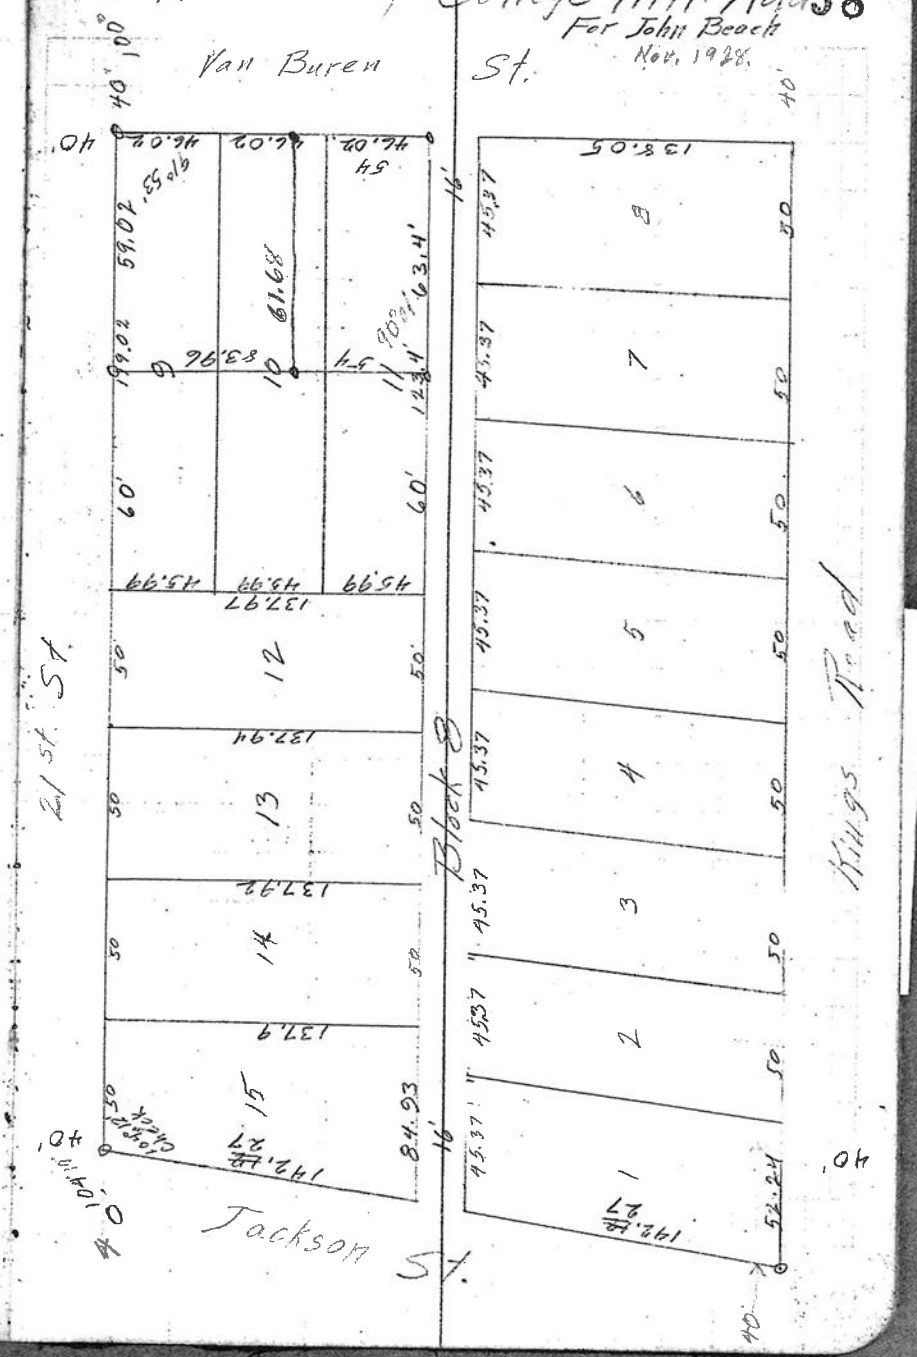
Nov. 1928.