C.S. # 1084

Hardcopy 10-5 #10

also see notes in file

F. B. 50-1

FB#50 Pgs. 1-3

C.S. 337 cont.

Survey for Govier

Nov. 19, 1928 beginning A

S 5°12' E

0°12' R corrected W 5°12'

= South

+5°30' 3.327	3.310		
		0°12' R	.006 W
+3° 1.687	1.685	"	
+4°45' 3.296	3.286	"	
		0°0'	.012 W
+12° 3.411	3.336	11.617	
		0°31' R	
+4°20' 2.823	2.815		
		0°33' R	.025 W
+9°15" 4.681	4.620	9.058	
		0°55' R	.047 W
+6°30' 3.040	3.022		
		1°51' R	.101 W
+20°30' 3.658	3.654	"	.116 W
4.558	4.558		
		1°39' R	.167 W
-2°40' 2.489	2.486		
		1°20' R	.091 W
-13°40' 3.171	3.079		
		1°08' R	.069 W
-4°30' 3.529	3.518	39.369	
			.070 W
		122°25'	
	3.84	N 71°08" W	

To 1/4 Sec Cor, 34-35

1084

T. 16 S R 5 W.

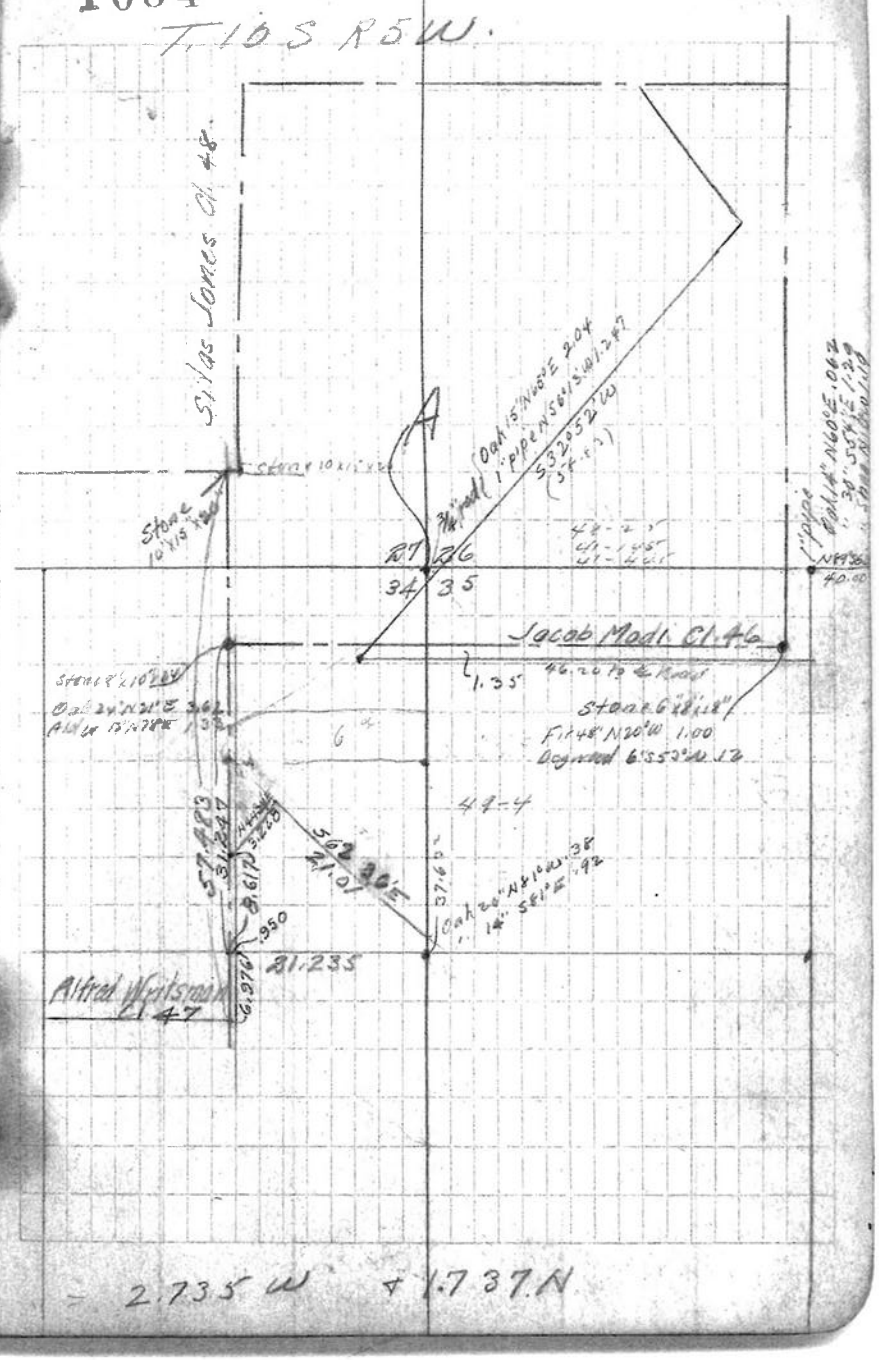

Azimuth

92°01'R

West = S86°49'W

0°18'R

.041N

0°12'R

.041N

.016N

R3°22'R .017N

.1.036N = 121.235

hit 3970

@ 12 N of Oak State

93°20'R

N0°09'E

2°22'L

N2°04'W

pt. in R .100W of Co. Road.

0°0'

.211 W

Mag N5°E

+ .504 creek

+2.584 hit 077 Way Stone cr on fine line

0°17'L

.050W

N.
041
041
016
017
1.036
1.151
1.629
.478 39.369
1.737
37.632

.100 W
.211 W
.311 W
077 E
.234
.234 +
10560

W
.006
012
025
044
101
116
164
071
069
070
.678
R1.735 = 5°12'
.09069
37.632 3.413

.047 SE
Set .032E + .032N
.100 W
.211 W
.020 W
.391 W
31.247

.100
.211
311
077
.234

.0075 - .026W

40.00
8.49
31.51

5775
8.49
49.26

.012
4.925
1.820
2.428
8.585

8.585
5.097
20.821
16.004
50.507
6.976
57.483

8.585
5.097
20.821
34.503
5.840
28.663
+2.584
31.247

Back to hub on ℄ Road

46°22'R

3.275

N44°09'E

13°0'R from Back line

6.420 6.393

S62°47'E

2.675 2.642

0°38'R

2.690 2.674

Mag 35½°E

0°38'L .030

2.662 2.679

0°0 .030N = 0

4.740 4.735

S62°47'E

1°11'R

1.901 1.901

21.024 ft 21.0

S61 36E

3240

S71 08E

hub

121°17'L to line N

bit 037 N ⌀

½" pipe

½" pipe

21.024
0 ft
21.010

Line hits 04 N of ½ cap
5½" pipe
Ft 20" N6°E .145
" 16" West .092

4611 CS 337 1084

SEC. 27,28,34,35 TOWNSHIP 10 SOUTH, RANGE 5 WEST.

PLAT NO. _____ NAME OF OWNER John S. Govier Est.
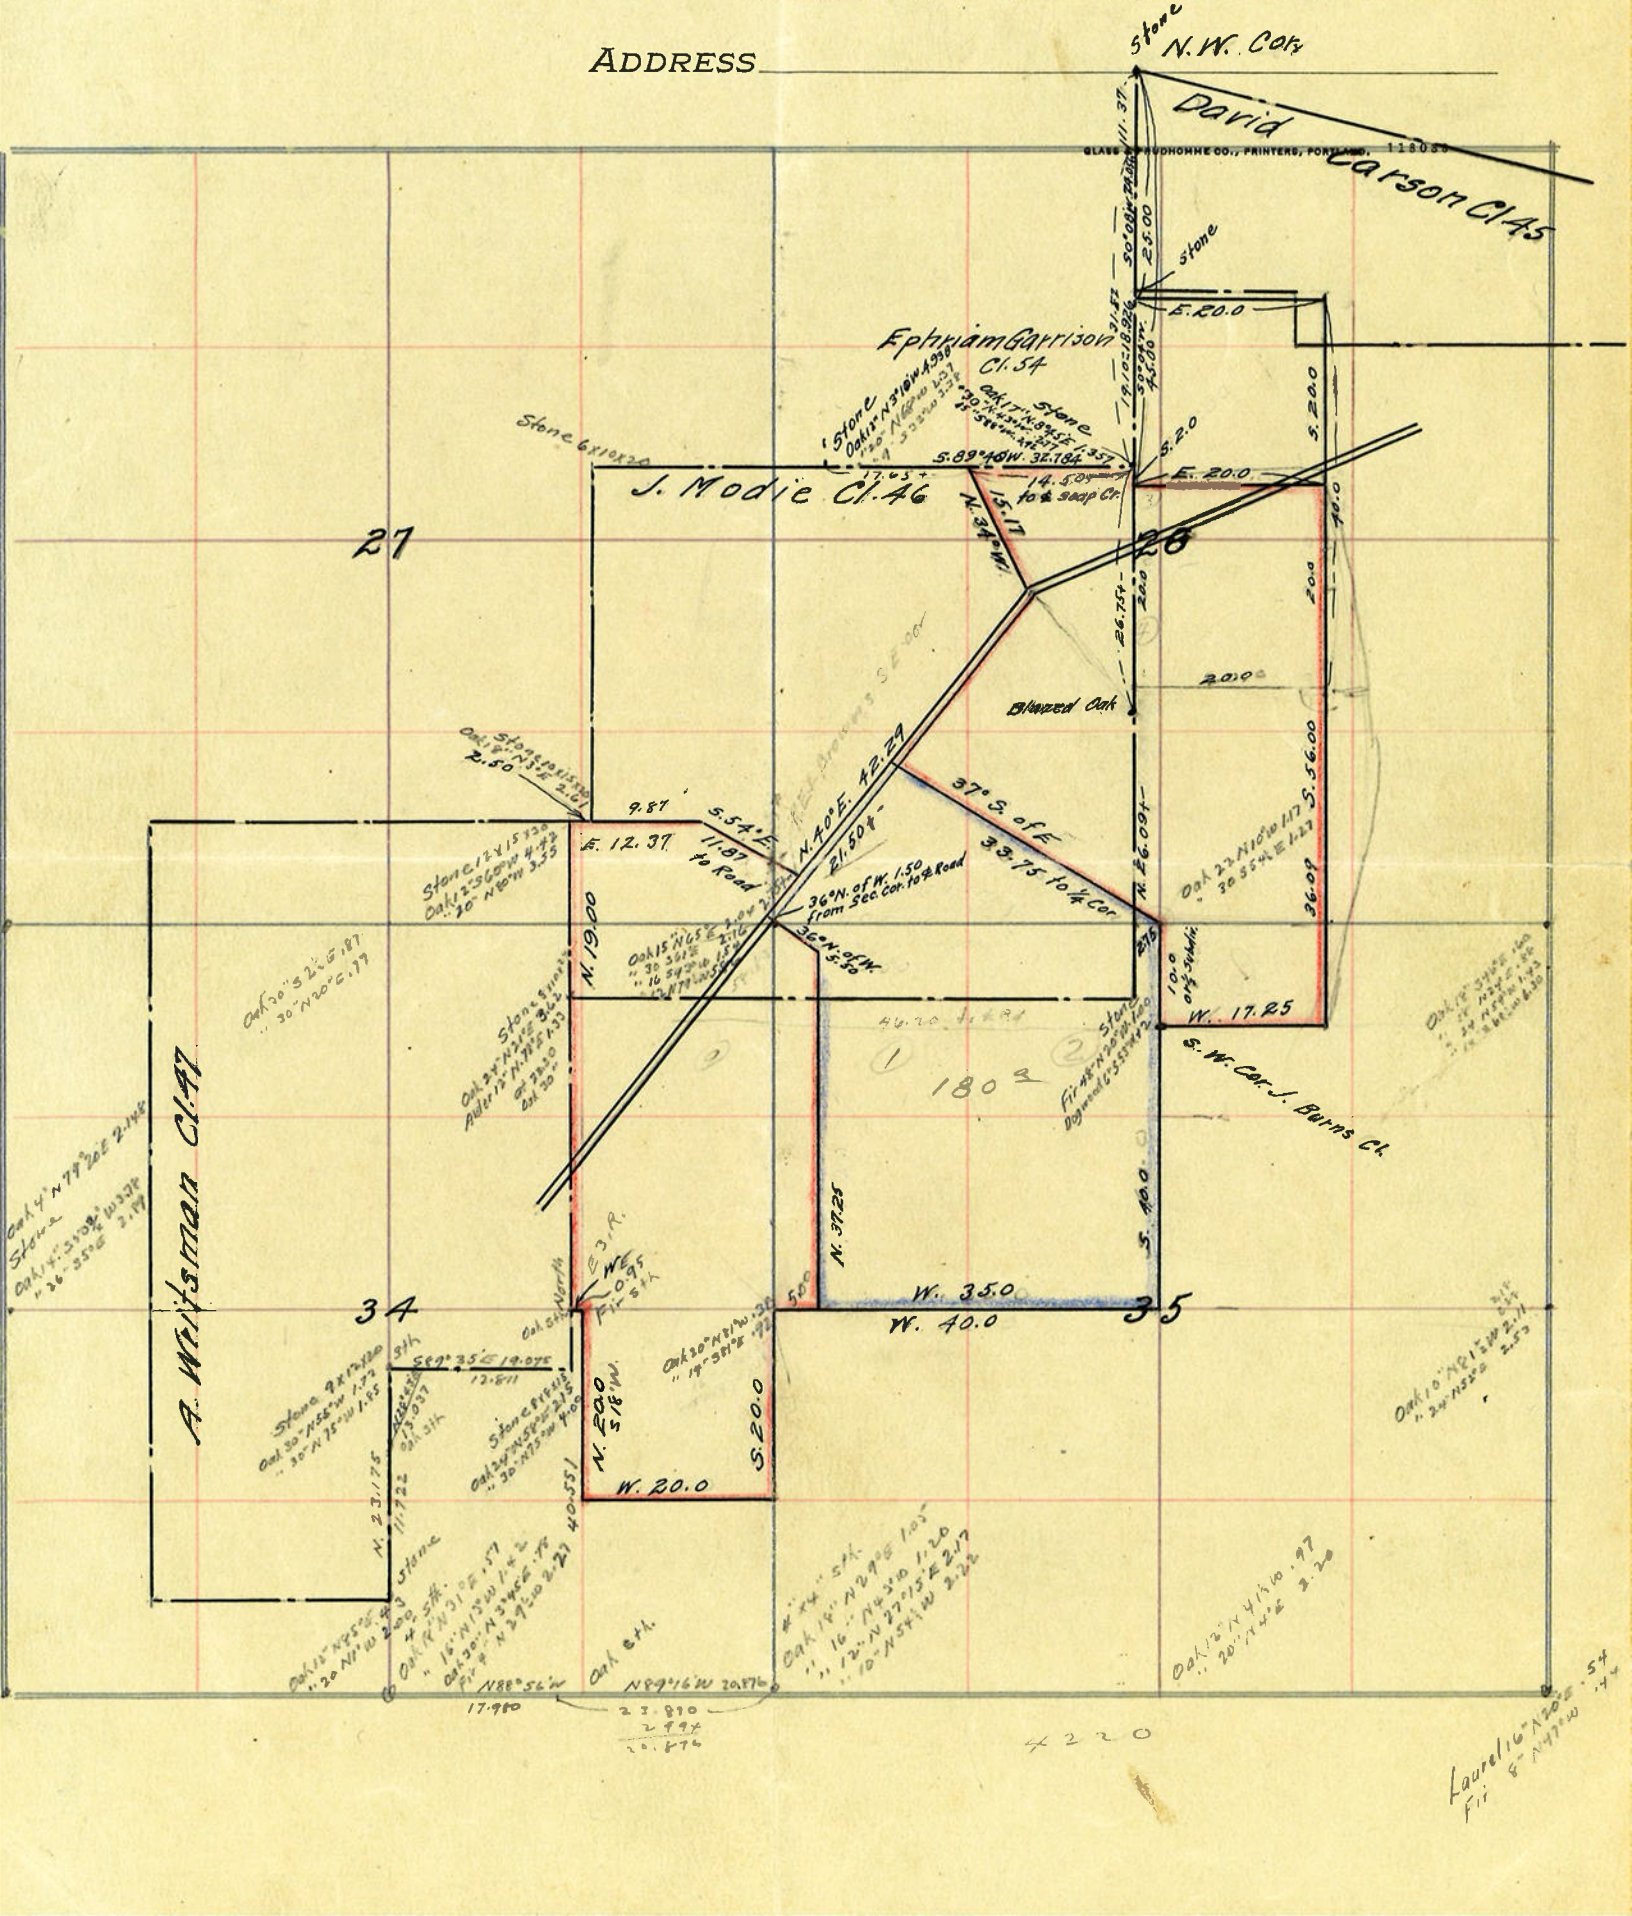
ADDRESS _____