C.S. # 1086

Hardcopy 10-4 # 21

also see notes in file

F. B.

12 1086 FB#38 PGS. 12-13

C.S. 499 Continued

T.M. Read D.L.C. T.10-4

Nov. 27, 1928 For Walter Read

Beginning at ℄ of R.R. on S. line of Read claim Bearing of R.R. N.39°41'E. .587

N89°53'E. Set a ¾" galv. pipe

Trav. 1	N.39°41'E. along ℄ R.R.	25.736	-5.194	41's of gate
	Set a ½" galv. pipe			
	N.89°52'E. from pipe (correction 5.3')	8.000	S.007	
		8.000	S.	
	+1°	8.000		
	+2°30'	5.000		
	+3°30'	8.000	S.032	
	+10°	2.724	S.034	
2	+3°	5.086	S.038	
3	+11°40'	5.856	S.043	
4	+7°15'	1.350		
5		+.012	=51.827	

Set ¾" Shaft South .045 mound/ sharp S.18°E

Oak 9" S. 41°30' W. .104 3.98'L Oak 10" South .170

" 9" N. 76°30' W. .070

N.0°12' W. (correction E. ½')

6	-3°40'	2.593	=2.588	
7	-7°56'	3.718	=3.682	
8	-11°38'	2.530	=2.478	
			8.748	

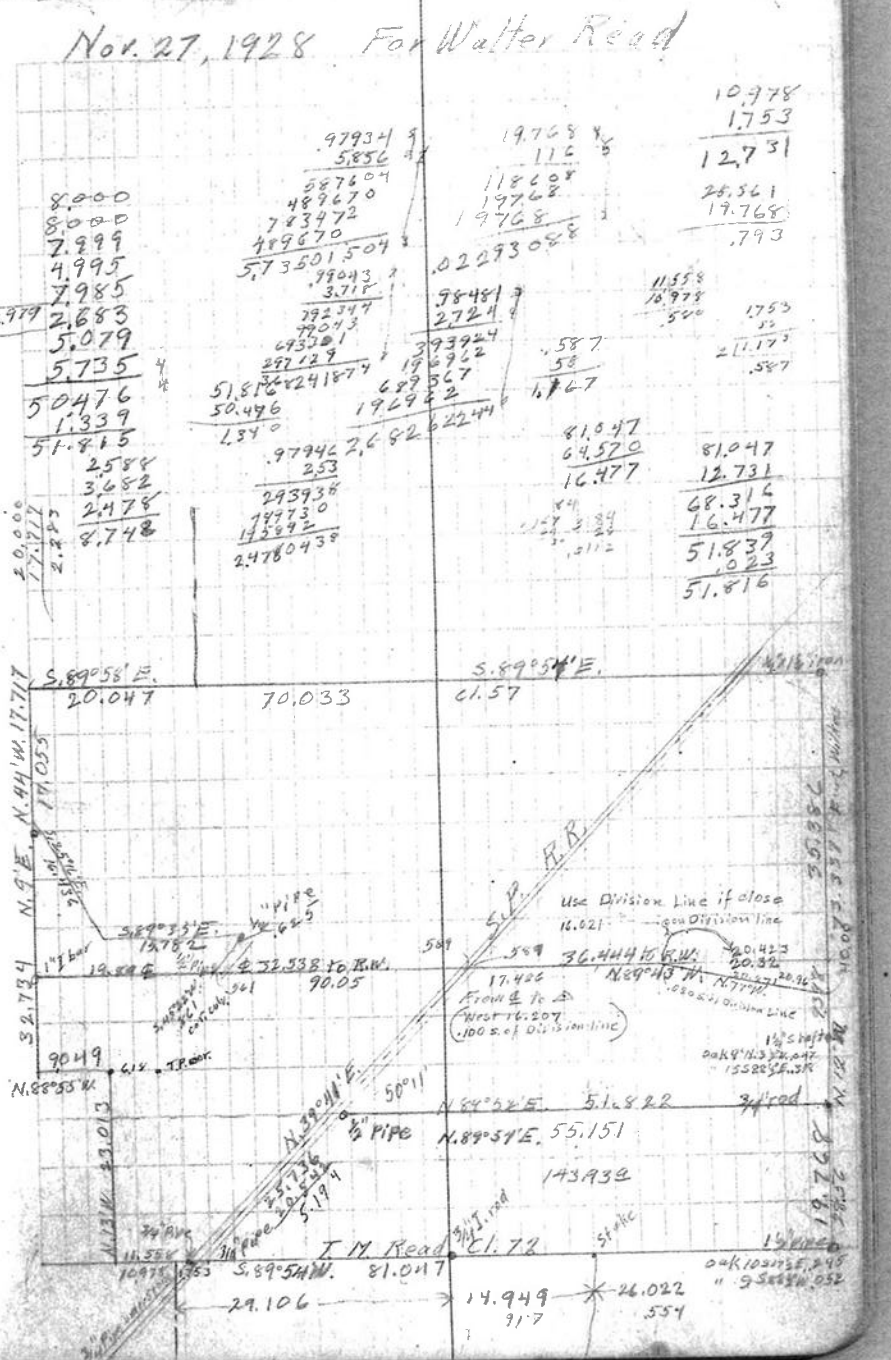

52-221

13

	Back to Δ	N.E. cor.	of S ½ of Claim		
9	S. 0° 12' E. correction W. ½'	+3°	4,523	-.490	
10			3,465		
		-3°20'	5.376		
11					offset
12	∠ Loc. N. 13° W.	-1°30'	2,233		.008 E.
To S.E. Cl. cor.	∠ "	2'	-4°	4,250	offset .002 E.

2,232
378
17856
15624
6696
.0084 3696

4.517
-3.982
535
045
490

4.240
58
3392
2120
.00245 92
175
20 1.0035
20
150
140
10

4.517
3.982
3.980

51.82 | .00087 = 3'
.045000
41456
35440

4.517
3.465
5.367
1,232
4.240
19.821
8.748
28.569

19.821
.008
19.813
19.768
.045

N62°10'E End of Fence
N63°51'E " " "
Ditch on E.R. 2.23
5.19
7.41
468' N. to cor.
710' N49°40' W. to cor.
N. 54°31' W. grain
N. 52° E. Field + Pasture N. + O