C.S. # 1087

Hardcopy 11-6 #8

also see notes in file

F. B. 54-1

F/B #54, Pg. 1

C.S. R46 Cor. 1

T. 11 S. R 6 W.

Survey for Peterson + McCready for Service Sta 1928
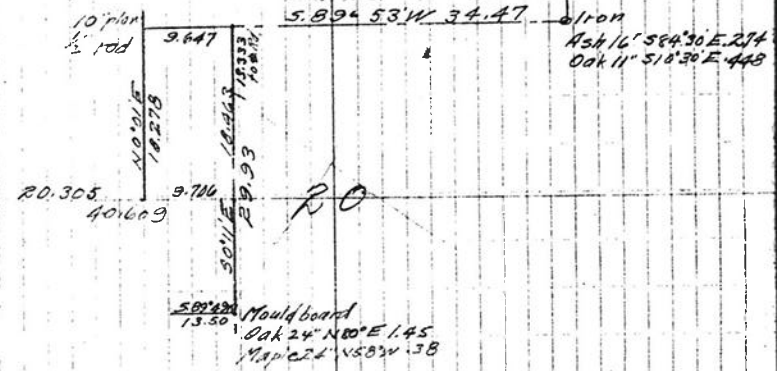
1087