C.S. # 1090

Original Town of
Marysville

Block 18

F.B. 84-67

FB #84

67

This seems to be.
GB Coon.
between 3rd & 4th
and Monroe & Jackson
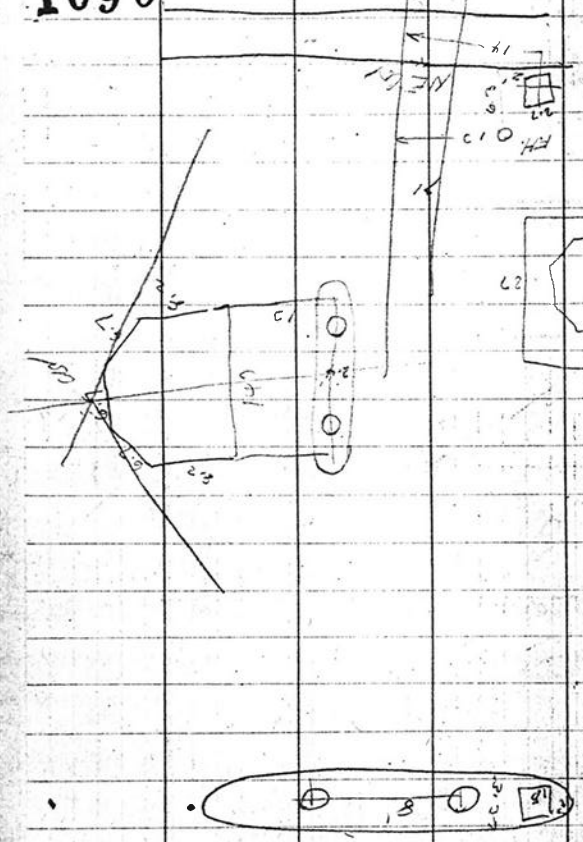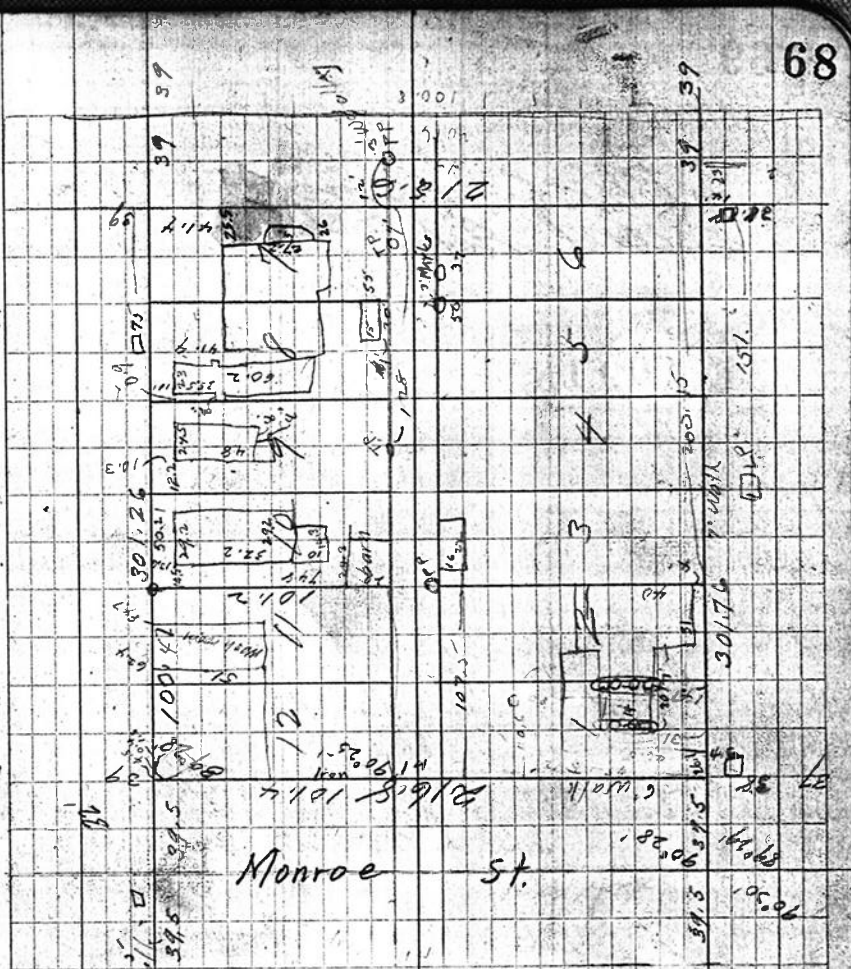
1090