C.S. # 1092

County Addition

Block 16

F.B. 84-71

FB #84

71

1092

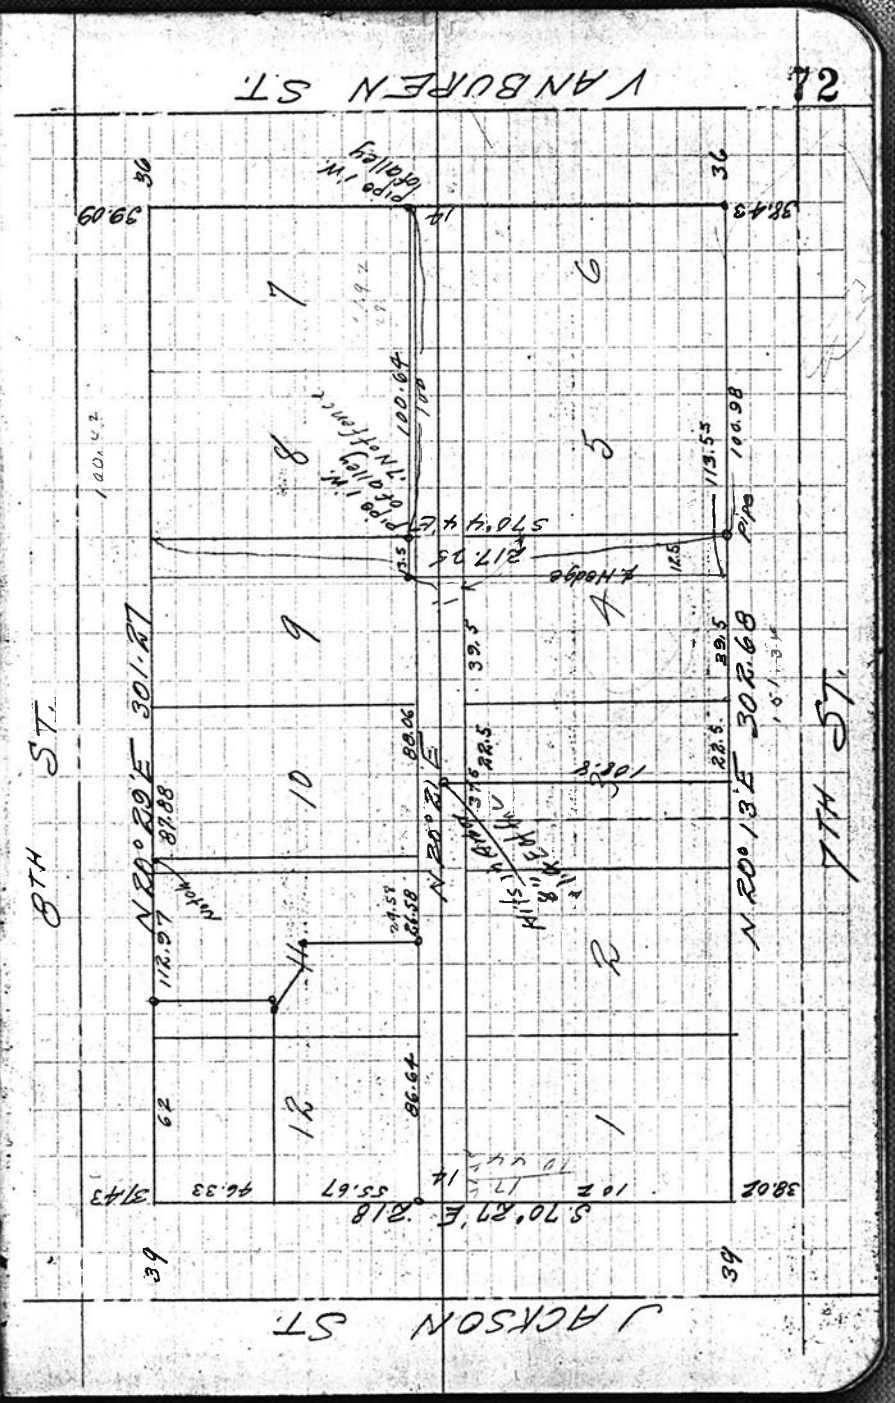

151.34
22.3
173.84

217.25
108.62
100.62

201.96
200.84
1.12
1090
300
218
820

20 - 21
70 44
91 05

218
217.25
.75

BLOCK #16 CS 1092

COUNTY ADDITION TO CORVALLIS
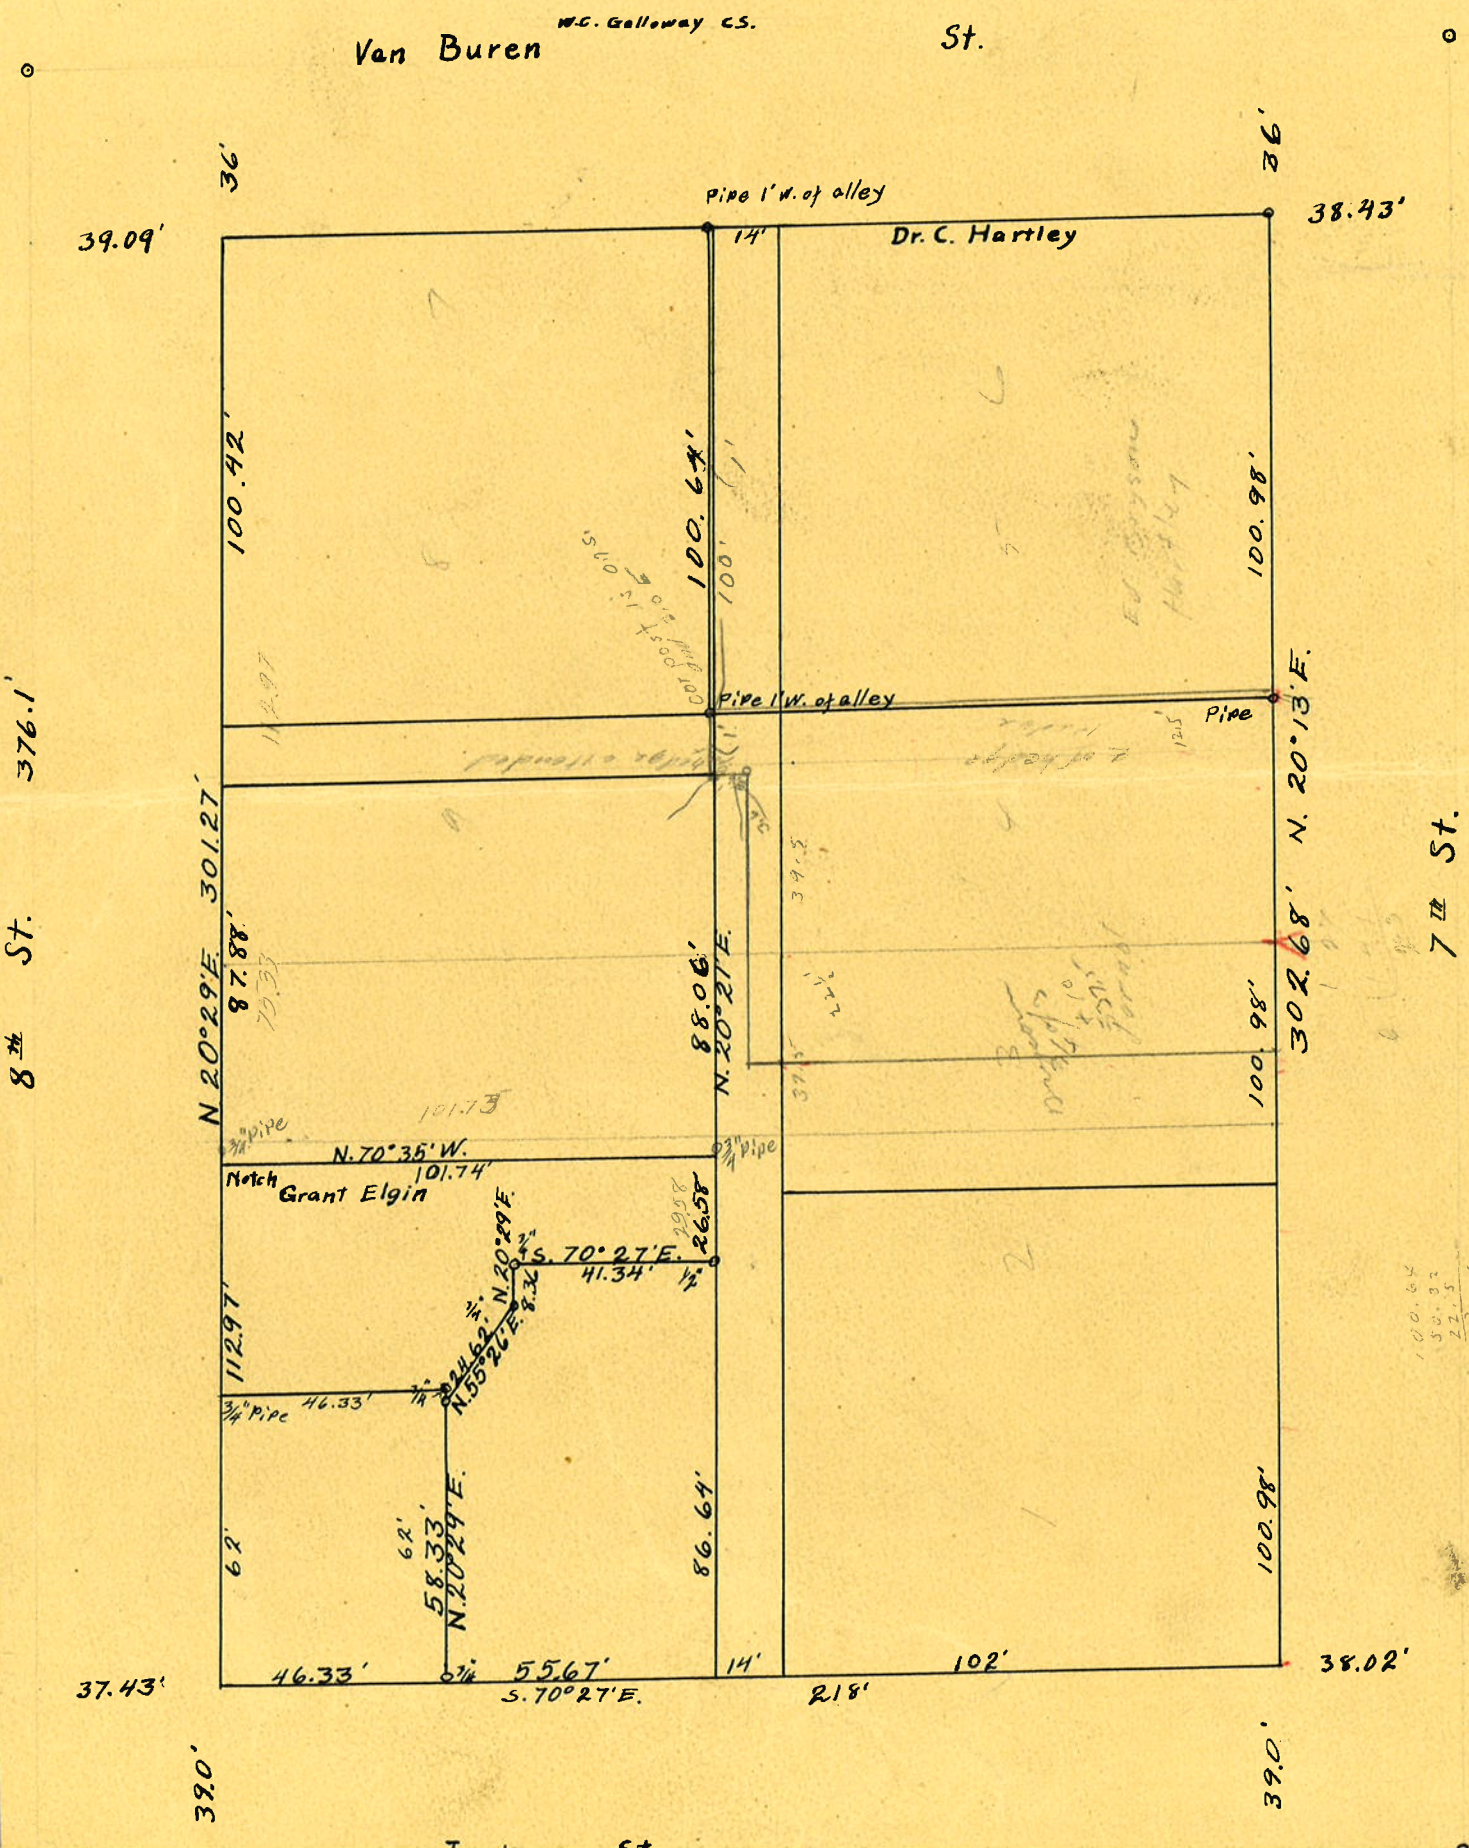
Scale 1" = 40'