C.S. # 1093

Original Town of
Marysville

Block 3

F.B. 84-73

FB #84

1093

E. side including ½ streets 384.96

275.85

N.E. Cor Jos. C. Avery Cl

¾" pipe Oak 18" N12°E 3.25 Stump

" 15 N19½°E. 2.66 Std.

¼ cor between Secs 2+3 T12-S
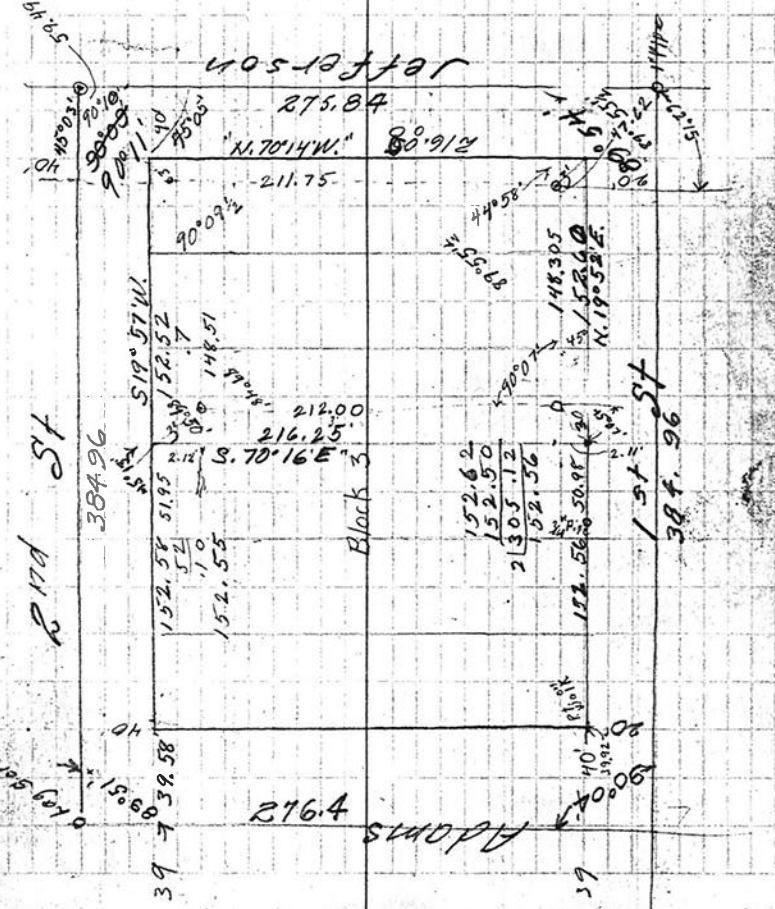
¾" pin Oak 24" S32°45'E 3.20 Stp