C.S. # 1095

Hardcopy 13-5 # 3

also see notes in file

F. B. 70-1

F/B 70, Pg. 1

C.S. 117

Survey for
Coyotte Lumber Co.
1929

Began at a bolt set on West side of pavement on south line of Lewis Dennis Cl. Run S.89° 51' W on Cl. line 5.780 chs. Set 3/4 pipe .455 N. Continue S89° 51 W 1.318 to line of fence N. Set 3/4 pipe .455 N and a 1/2" pipe 3.25 N. from ± of Road Continue Westerly 1.64 ±.

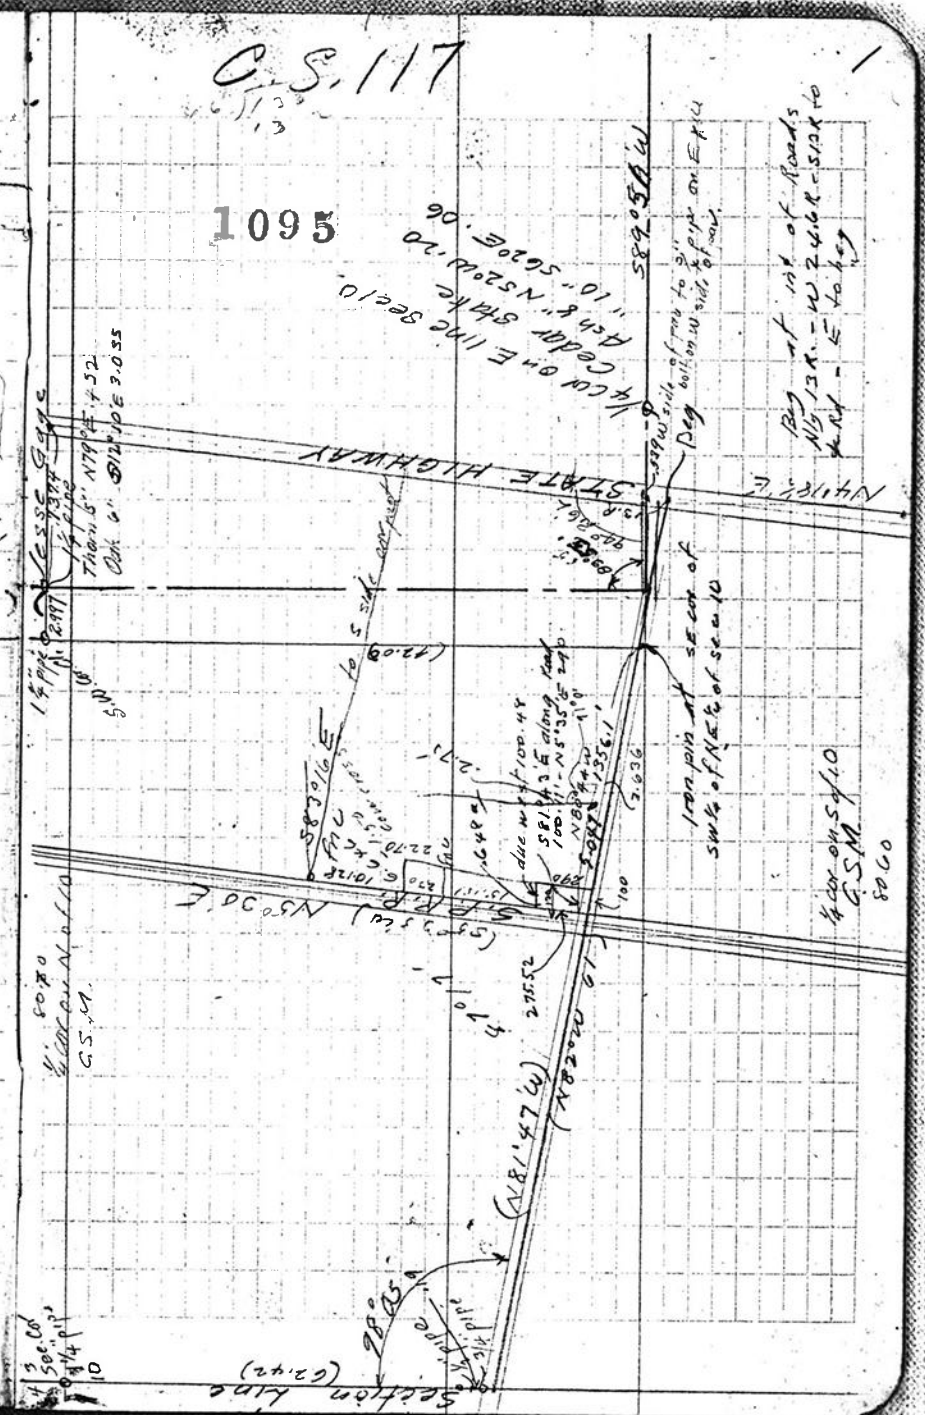
1095
STATE HIGHWAY
RAILROAD
Section line (62.42)
S 89° 51' W
N 87° 47' W
N 3° 00' E
S 89° 51' W
1/4 Cor on E line Sec 10
Ash 6" N 52 W 0.46 from pt on E line
Oak 6" S 19° E 3.055
Set 3/4 pipe
Iron pipe at SE cor of SW 1/4 of NE 1/4 of Sec 10
N 1/4 - E to beg
