C.S. # 1096

Hardcopy 11-5 #9

also see notes in file

F. B. 38-15

15

C. S. #60 Resurvey

Sec 21-11-5

1096

27°40'
1° 45
25° 55'

.303

+3°30' 8000 -.023
1.838

7.985
.023
7.962
1.838
9.800
.266
10.066

10.324
10.066
.258

Oak S.79°W. .084
" N62°20'W. .315
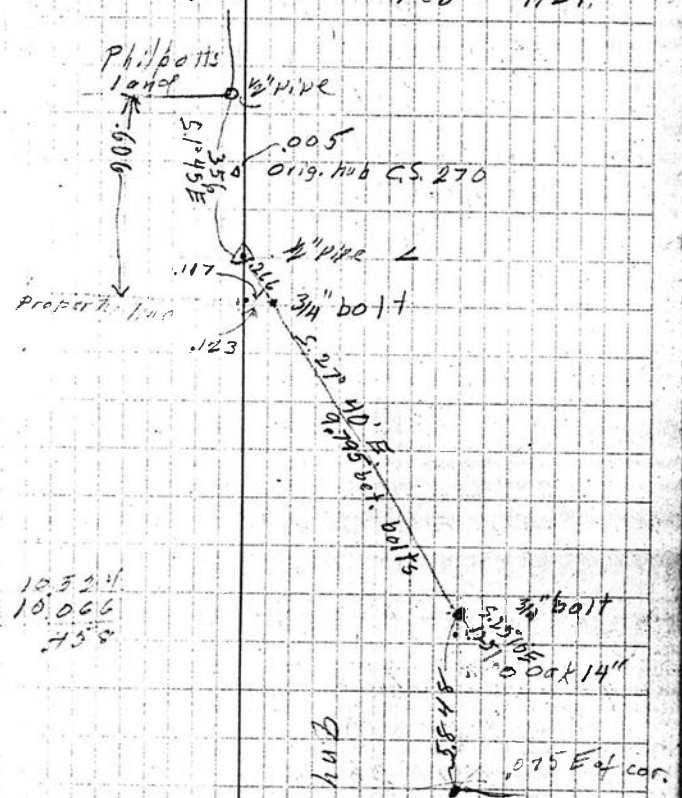
J. F. Yates
Feb 1929.