C.S. # 1098

Hardcopy 10-5 #5

also see notes in file

F. B. 50-4

FB #50

1098 T. 10 S. R. 5 W

Assume Creek bed as 300'

Water Level 8' below bridge deck

Bottom of creek 11 " " " "

H.I. 1,314.1 Set on pt. near W. end of Br.

A Bridge deck S40°E 5.1 25

approx. location of Pump 60's

	H.I.	N36½°W	620	5.4
B.	5.2			
		N58°W	3.57	0.9
C	5.2			ditch 1 power
		E	40	Wiles drive
~~D.~~		N42°W	880	14.8
D.	5.2	16.3 of fnc	+8½°W	
		N82½°E	347	to C.L. Cor
		N52½°W	237	7.7
E	5.2	N77°W	to N.E. Cor Old hse	
		N59°W	pig pen	-1.0
		N38°W	Straw pile	
		N27°E	S.E. Cor Woods	-0°30'
		N31½°W	480	9.3
F	5.2	N45°E	S.E Cor Woods	
		S81°W	N.E Cor Old hse	
		N75°W	Pig pen	
		North	400	Brush
		N41°W	750	9.1
G	5.2	S43°W	NE Cor old Hse	Woods

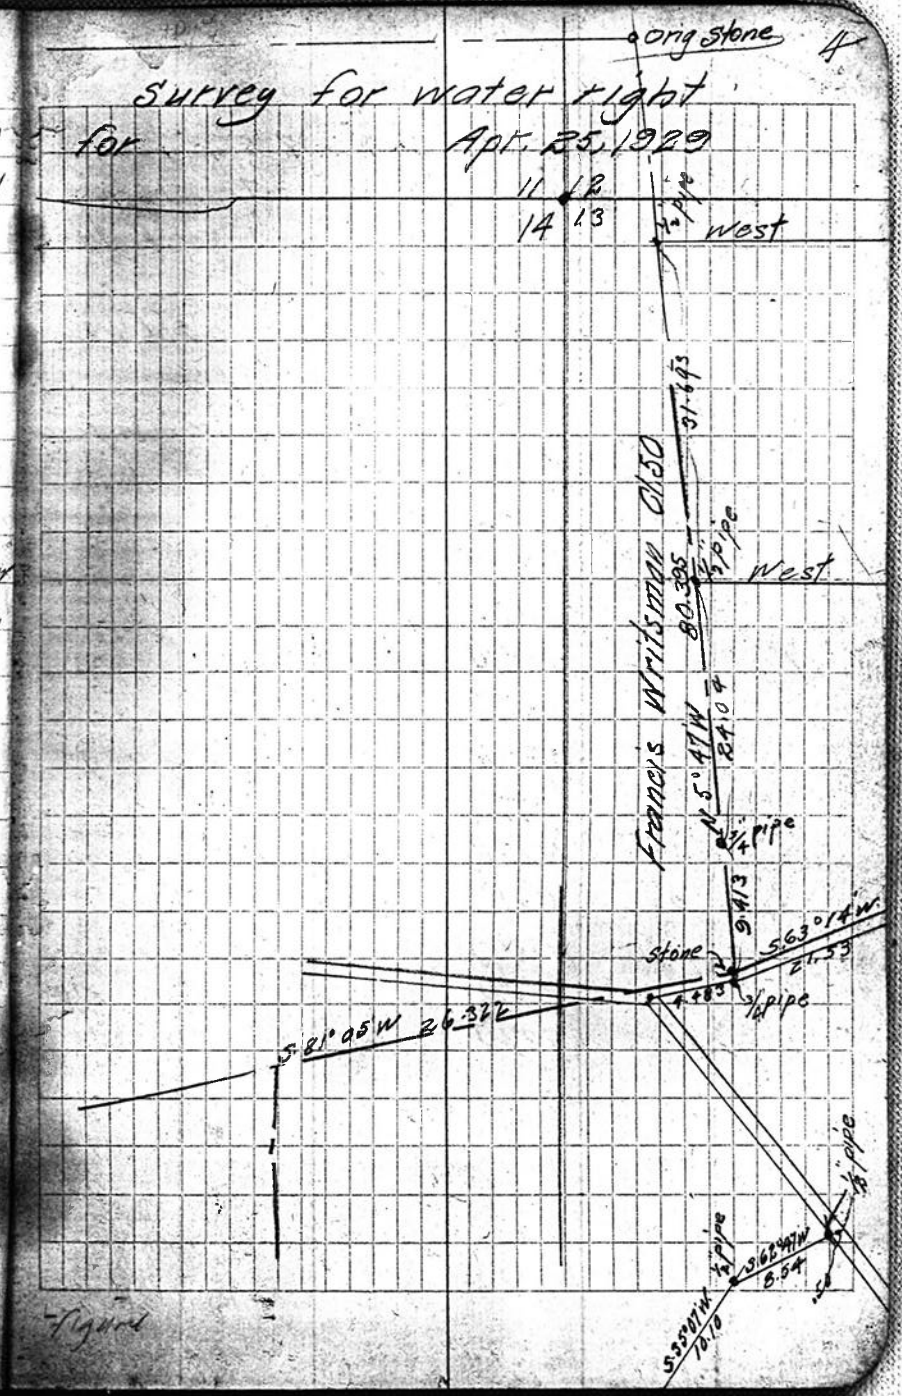

		N73°E	260'	7.5	S.E. cor Field
		N17°W	545	3.7	in field
		N4°E		N.E. cor field	
		N52½°W	580	0.2	
H	5.2	S21°W		N.E. Cor Old Hse	
		S51°W		pig pen	
		S44°W		N.E. cor garage	
		S62°W	W line	+1°0'	
		N60°E	720'	15.0	fence
		N23°E	1000'	18.0	
		N12½°W	910'	14.5	
I	5.2	S80°W	470	2.0	Field line N + S.
		S25°W			pig pen
		S31°W		N.E. cor garage	
		N53°E	800'	fence	
		N10°W	600	11.0	
J	5.2	N61°E	390	8.5	Fnc + Wdl
		N10°W	380'	8.2	fnc.
		N50°W	1500	NW Cor F.A.	
		S8°W	+0°40'	N.E. Cor Old Hse	

Pt. of distribution from pipe