C.S. # 1101

Hardcopy 12-5 #28

also see notes in file

F. B. 59-1

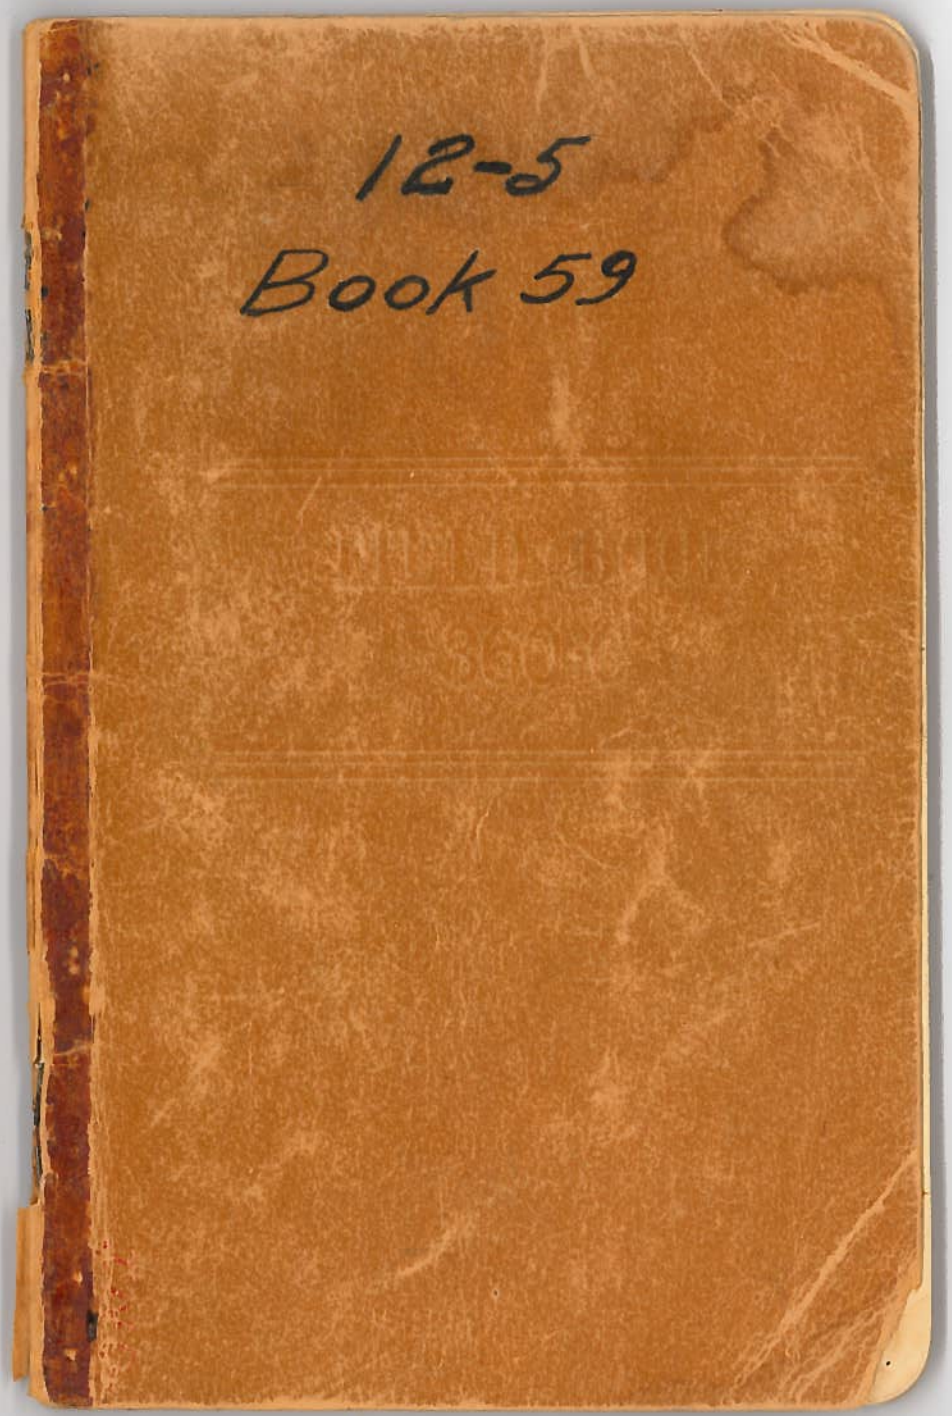
12-5
Book 59

Survey for Corvallis Orchard Co.
May 25 - 1929
Set on 1½" pipe ± Road N.
Az. C.S. 124
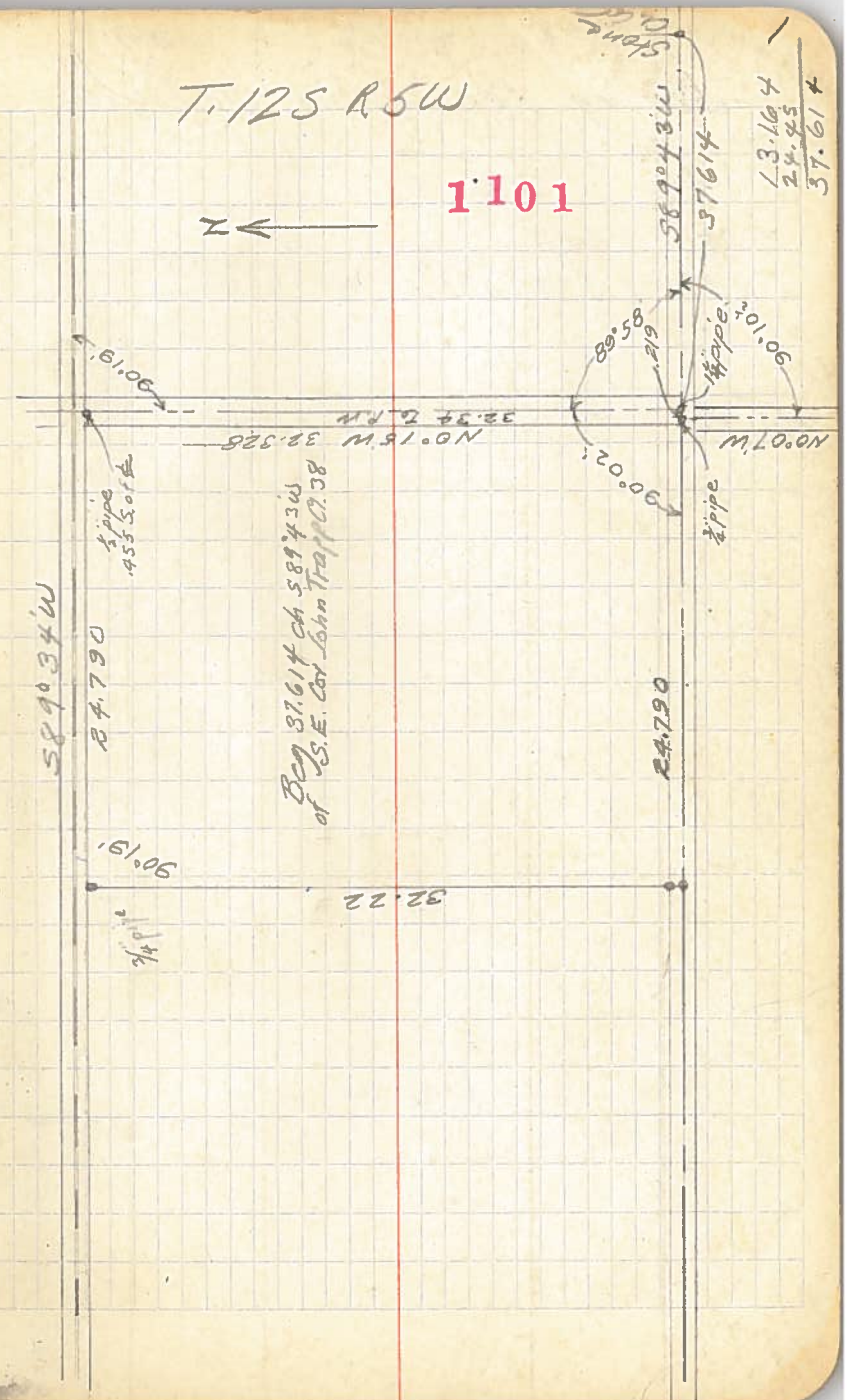
	Ram	North	= N 0° 15' W
32.328 △		½" pipe	
24.783 +3° △		W	
4.121 +2.30	4.115		S 0° 15' E
3.498	3.495		
		0°04'	
5.003 +3°	4.996		
		0°04'	.006 E
3.718 +3½°	3.711		
		0°30'	.0004 W
4.723	4.723		.041 E
4.853 -2.30	4.848		.042 E
4.861 -1.40	4.861		.042 E
1.484	1.480	37.229	
		90°05'	.013 E
10.00 -5½°	9.954		
10.00 +1°	9.994		
4.706	4.706		
		24.654	
		+140	
		24.794	
			.144 E
			.004 W
			.140 E