C.S. # 1103

Hardcopy 12-5 # 24

also see notes in file

F. B. 59-3

FB #59 Pg. 3 CS. 257 1939

Survey for Parks

Began at N.E. Norris P. Newton Cl. 72 T12S R5W

5000	5.060	West		1103
5.000	5.000			
+2½" 5.000	4995			
+6½" 4.085	4.059			
-3½" 4.380	4.371			
-5/10 5.000	4.960			
10.000	10.000	38.385 + 1.514 = 39.899		
.61	.615		Δ +1.514	¾" pipe
	40.000			
40.417				
		¾" pipe Cl. Cor		N.W
	Set on pt	39.899 W of NE Cor Cl.		
4.820		~~East~~	N 89° 43' E	
		33°28' R		
9.090			S 56° 49' E	
		90°37' R Az.		
5.405			S 0° 20' W	
		46°57' R		
7.081			S 43° 20' E	
		166°10' L		
17.660			~~S~~ 75° 53' ~~W~~ = S	
19.834			N 0° 17' W	

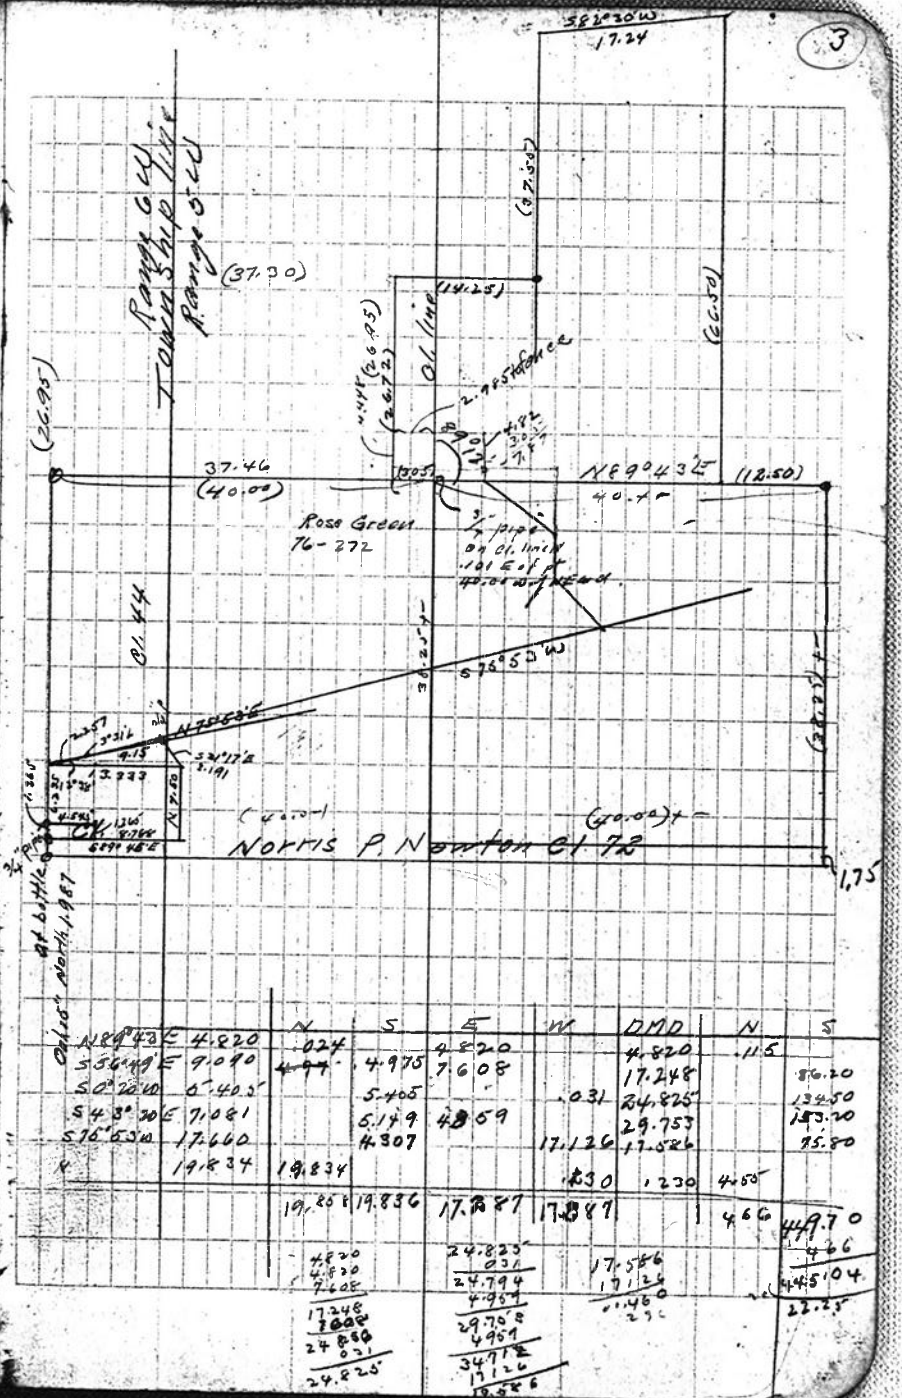

Calc's		N	S	E	W	DMD	N	S
N 89° 43' E	4.820	.024		4.820		4.820	.115	
S 56° 49' E	9.090	4.97	4.975	7.608		17.248		86.20
S 0° 20' W	5.405		5.405		.031	24.825		134.50
S 43° 20' E	7.081		5.149	4.859		29.753		153.20
S 76° 53' W	17.660		4.307		17.126	17.586		95.80
N	19.834	19.834			.230	.230	4.605	
		19.858	19.836	17.287	17.387		4.66	449.70
							4.66	
								445.04
								22.25

4.820
4.820
7.608
17.248
7.608
24.856
.031
24.825

24.825
.031
24.794
4.959
29.708
4.959
34.712
17.126
17.586

17.586
17.126
.460
.230