C.S. # 1107

Hardcopy 10-6 # 17

also see notes in file

F. B. 43-2

1107

C.S. 147 FB# 43 Pgs 2 & 3

Survey for Braley + Maxfield

1929

2

Set on pt .053 N. of ½" pipe which is 3.41' S. & W. of Cl. Cor

Sight on stone Cl. Cor N

Set on pt .065 N of ½" pipe (Near N.W. Cor of 50)

F.S. on Cl. Cor N - 89° 55' E

2.901	2.856
3.067	3.067
5.637	5.637
	11.570
5.000	4.951
2.270	2.257
	7.178
1.344	1.322
	5.000
1.390	1.382
R. 59	2.576
.81	.810
2.11	2.099
5.00	5.000
.77	.770
3.189	3.157
2.52	2.520
4.130	4.126
	0° 20' R
4.223	4.223
	40.163

= 87° 47½' to Hub .076 to Hub

.024 N

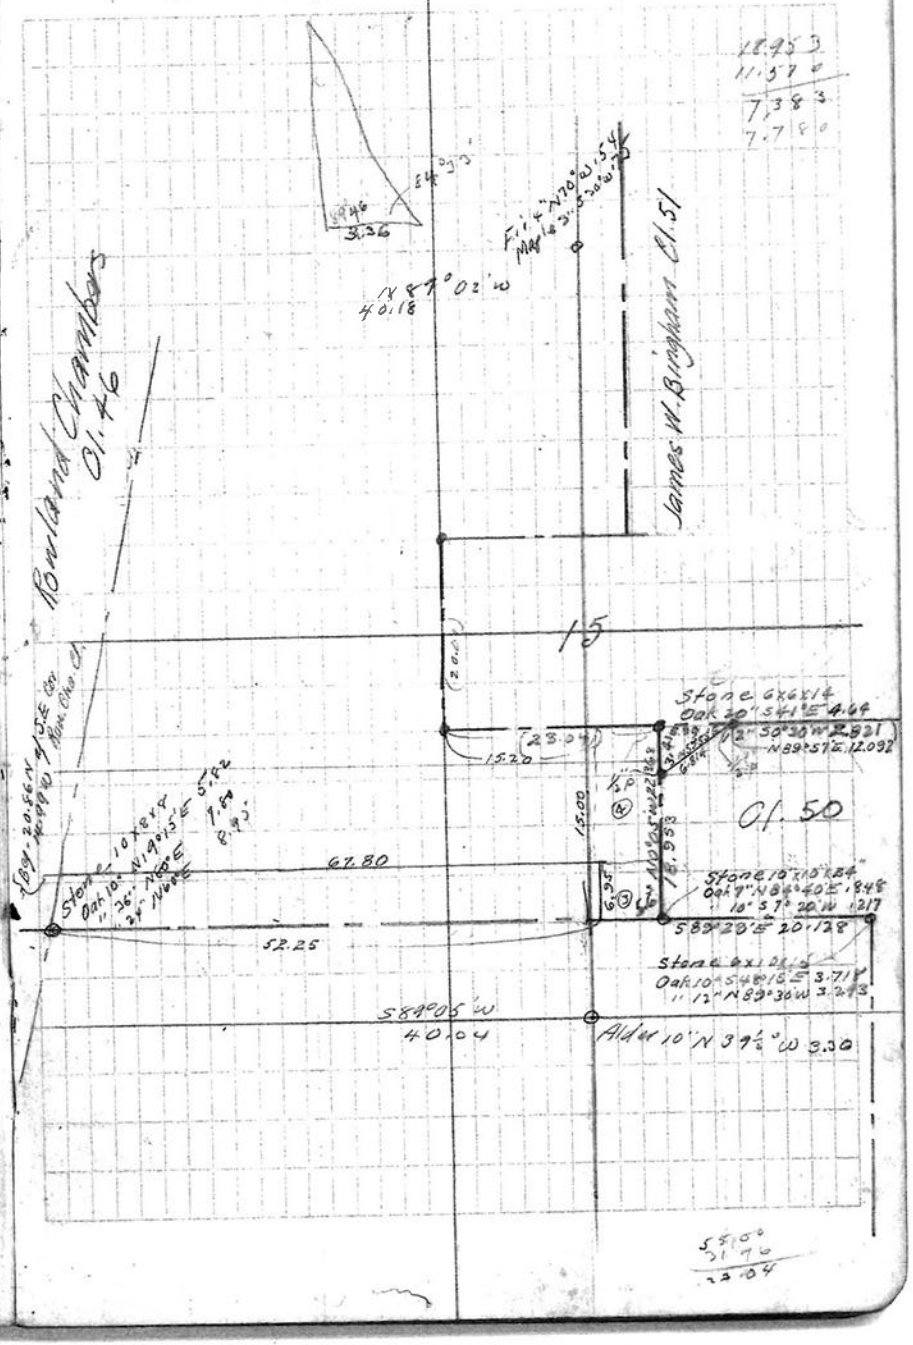

+2.163

Set

0°20'L

2.141 (−3°) 2.138 0°0'

0°20'L

1.221 (−1°) 1.219

Az. 0°58'R

1/2 way .32 W

1.437 (−16°30') 1.386

1.952 (−31°10') 1.670

5.000 (−1°20') 4.890

1.066 (−13°20') 1.039

.0075 60.182 52.504 7.651

52.504

0°0'

.152N

5.000 (−11°) 4.905

2.700 (−8°) 2.613

60.182

90°0'

Set 3/4 pipe .031 S.

11.322

South

S88°38'W

Set 3/4 pipe

5.000 (−4½°) 4.985

8.762 8.762

13.747

Alt 12" East .213

N.W. cor Maxfield

3304

Schuler .135 N

.065 .203

8.985

12.854 7.783 10.627

.024 N .152 N .176 .0075 .169 N

609³

.1564 13.17 10948 1564 7820 1564 2.3726 18.50 21.87

.024 N .007 .017 .12

13.76 11.30 60.18 185.24 42.62

4.981 4.839

0°67'L

2.795 5.000 (−5°40')

SW. Cor Price Ct.

2.795 4.988 7.783