C.S. # 1108

Hardcopy 11-4 #2

also see notes in file

F. B. 47-5

FIELD BOOK
360-C
Book 47
11-3
Book 47 11-3

5
1108

C. S. 279 Cor For Barker

Aug 12-1929

Set on 1/4 pipe the N angle Co of Rainwater Cl.

1.380 -9° 1.364 North

Back to Cl cor

.70 S86°E

.343

4.998 South

4.885

.751

.219 N74°08W (N Rail)

.83 S0°09W

¾ pipe in fence Cor.

		N.	S.	E.	W.	DMC	
S86°E	.70		.049	.697		~~.697~~	.034
South	9.35		9.350			1.394	13.034
N74°15E	4.489	1.219		~~4.320~~ 4.442		5.866	~~7.150~~
North	12.992	12.992				10.338	134.311
S80°38W			~~.852~~ 0.852		5.017 ~~5.169~~	5.169	4.404
South	3.96		3.960			1.00	
		~~14.191~~ 14.211	~~14.191~~ 14.211	~~5.169~~ 5.017	~~5.169~~		~~141.461~~ 17.472

23.9 6.18

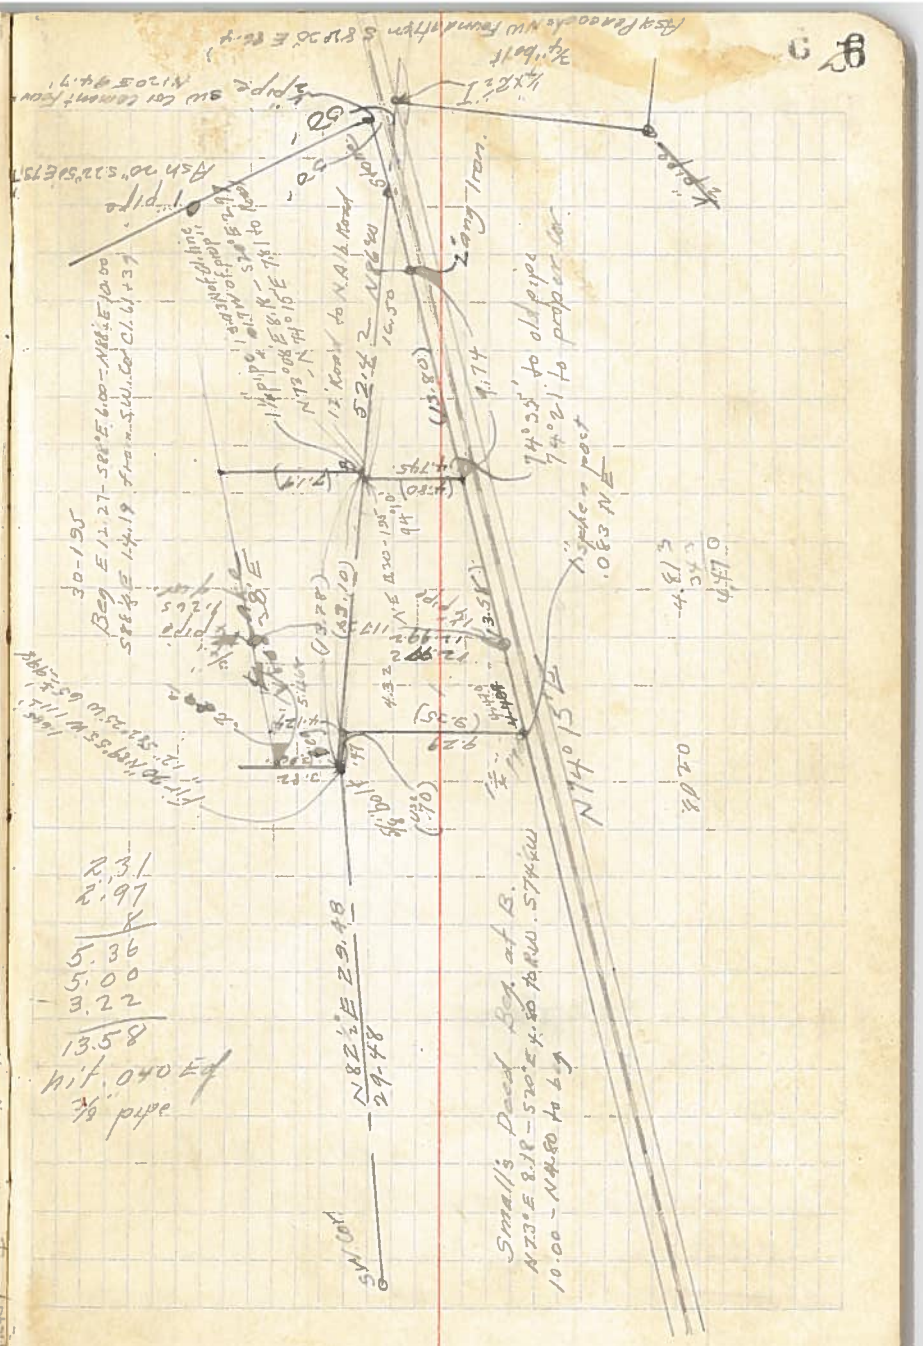

6